IREDELL COUNTY HEALTH DEPARTMENT

STATESVILLE 704-878-5305 MOORESVILLE 704-664-5281

11:00

IMPROVEMENT PERMIT / AUTHORIZATION TO CONSTRUCT / OPERATION PERMIT / EXISTING SYSTEM INSPECTION

PERMIT# Repair PIN# ~~4635-45-1319~~ 4635-43-7196 DATE 6/8/05

OWNER OR CONTRACTOR Anson Coffey PHONE: Business _____ Home 704-561-6455

ADDRESS 738 Isle of Pines Rd Mooresville NC 28117

LOCATION OSR, TL Isle of Pines, at End

SUBDIVISION Isle of Pines BLOCK / SECTION 2 LOT 16 LOT AREA _____ SITE CLASS. PS DESIGN FLOW 480 L.T.A.R. —

Septic Tank: ~~1000~~ 1500 Gallons; STB 338 Date 1/22/06

Pump Tank: _____ Gallons; PT _____ Date _____

Pump Make: _____ Model _____ Serial No. _____

Nitrification Field: No Fields 1 Square Feet 1080 Linear Feet 360

No Lines 4 Trench Width 36" Max Trench Bottom Depth 24" Gravel Depth _____

☐ New System ☒ Repair System Type: I (II) III, IV, V, VI

System Description: _____

Repair System Description Gravity 25% Reduct.

Maintenance Agreement Required: ☐ Yes ☒ No

☒ House/Mod. Home No. Bedrooms 4

☐ Mobile Home No. Bathrooms ____

☐ Business No. Employees ____

☐ Other _____

☐ Slab ☒ Crawl Space ☐ Basement w/plumbing ☐ Basement wo/plumbing


Water Supply: ☒ Individual ☐ Public ☐ Community

Comments:/Conditions:


Install Drain lines on Contour

Comments:/Conditions:

INITIAL SITE SKETCH

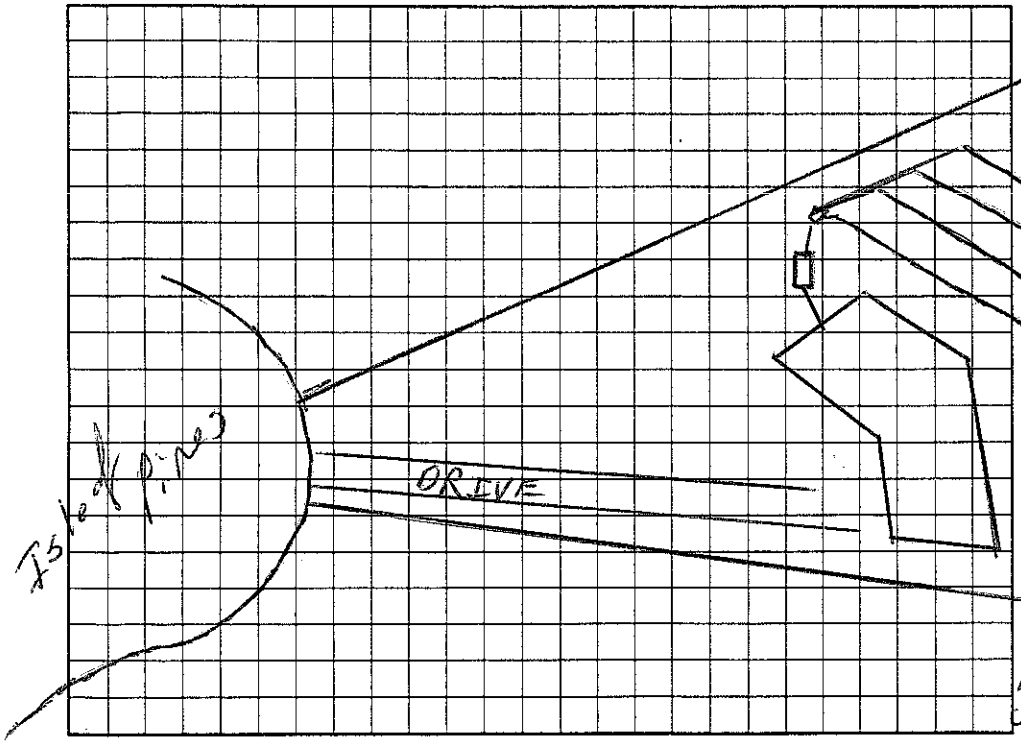

AS BUILT SKETCH

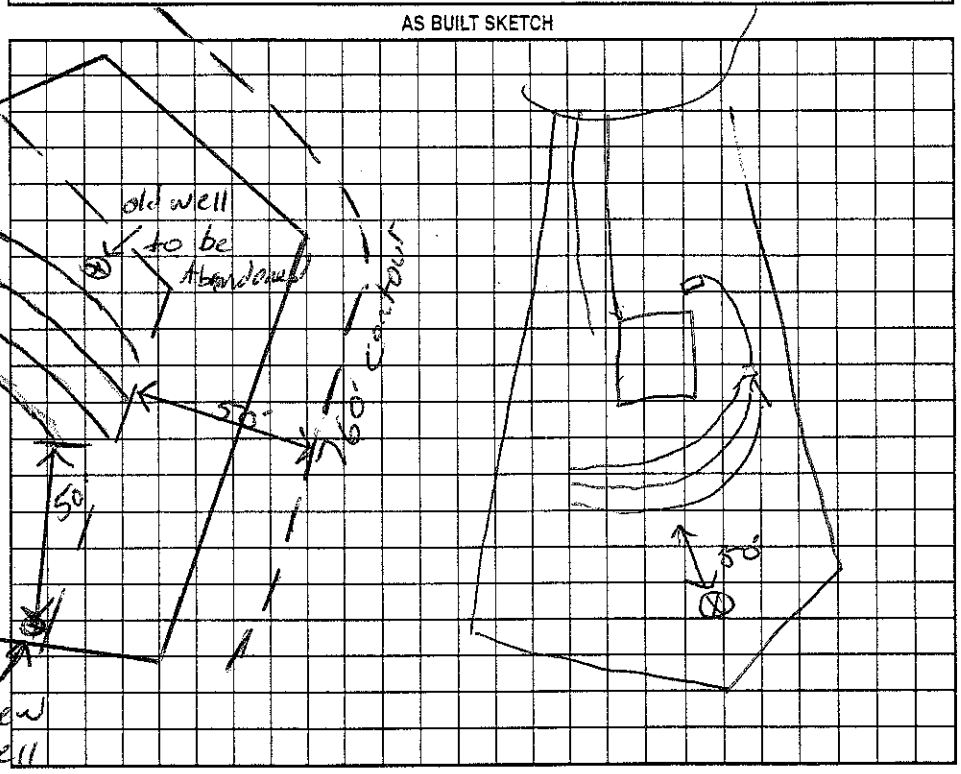

Permit can be suspended or revoked if any false information is supplied toward securing the permit/any unauthorized changes are made to the site/any unauthorized changes are made in the installation of the system. Improvement Permit with plat valid without expiration. Improvement Permit with site plan valid for sixty months. Authorization to Construct is valid for a period equal to that of Improvement Permit – not to exceed sixty months.

Signed: _____ date 6/10/05 Installed by: Christenbury

Improvement Permit by: _____ RS date 6/8/05 Operation Permit by: _____ RS date 5/2/06

Authorization to Construct by: _____ RS date 6/8/05 Existing System Inspection by: _____ date _____

HEALTH DEPT. COPY: WHITE OWNER COPY (FINAL): YELLOW OWNER COPY (INITIAL): PINK