IREDELL COUNTY HEALTH DEPARTMENT

STATESVILLE 704-878-5305 MOORESVILLE 704-664-5281

IMPROVEMENT PERMIT / AUTHORIZATION TO CONSTRUCT / OPERATION PERMIT / EXISTING SYSTEM INSPECTION

PERMIT# Repair PIN# 4635-35-8448 4635-43-9974 DATE 6/1/05

OWNER OR CONTRACTOR Doug McNeill PHONE: Business 664-8490 Home

ADDRESS 656 Isle of Pines Mooresville NC 28117

LOCATION Brawley School Rd, TL Isle of Pines, at end on Lt #727

SUBDIVISION Isle of Pines BLOCK / SECTION 2 LOT 18/19 LOT AREA SITE CLASS. PS DESIGN FLOW 450 L.T.A.R. —

Septic Tank: 1000 Gallons; STB 794 Date 7/25/05
Pump Tank: Gallons; PT Date
Pump Make: Model Serial No.
Nitrification Field: No Fields 1 Square Feet 960 Linear Feet 320
No Lines 5 Trench Width 36" Max Trench Bottom Depth 24

☐ New System ☒ Repair System Type: I II III IV, V, VI
System Description:
Repair System Description: Gravity 25% Reduct.
Maintenance Agreement Required: ☐ Yes ☒ No
Gravel Depth —


☒ House/Mod. Home No. Bedrooms 4
☐ Mobile Home No. Bathrooms
☐ Business No. Employees
☐ Other
☐ Slab ☒ Crawl Space ☐ Basement w/plumbing ☐ Basement wo/plumbing

Water Supply: ☒ Individual ☐ Public ☐ Community


Comments:/Conditions:

Comments:/Conditions:
19

INITIAL SITE SKETCH

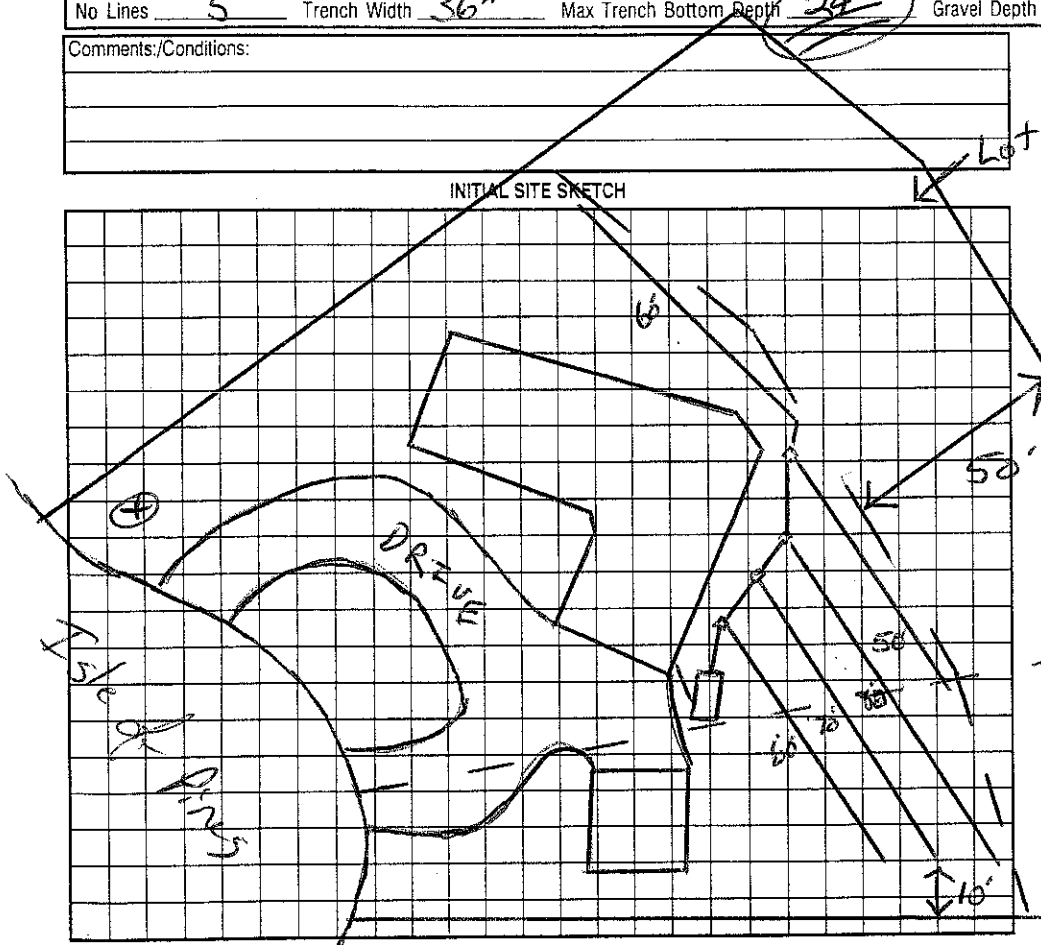

AS BUILT SKETCH

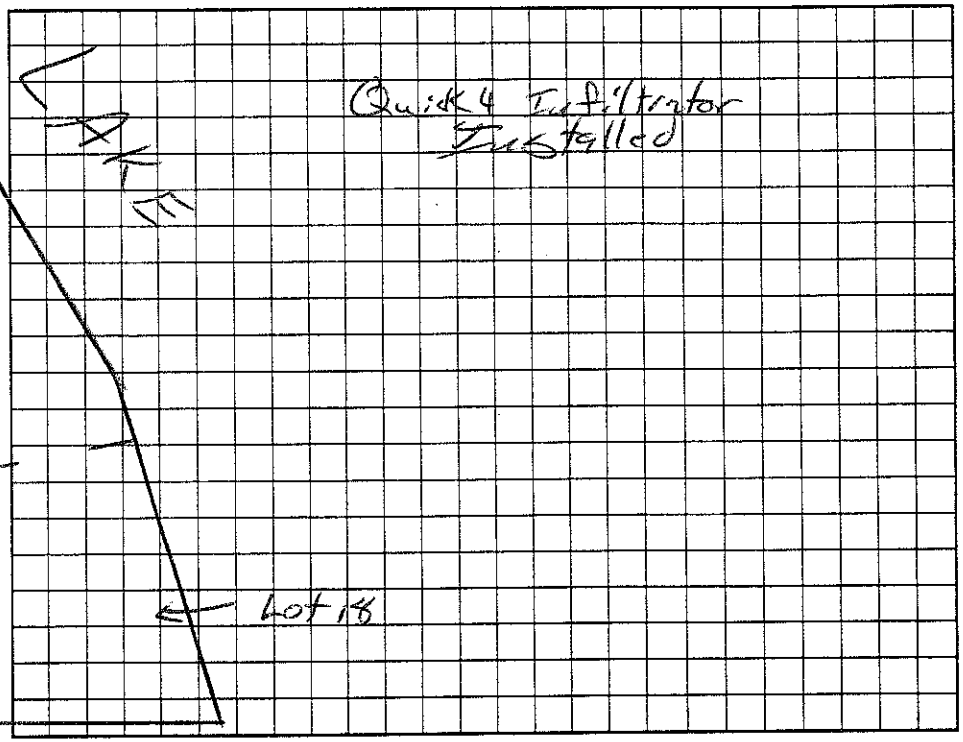

Permit can be suspended or revoked if any false information is supplied toward securing the permit/any unauthorized changes are made to the site/any unauthorized changes are made in the installation of the system. Improvement Permit with plat valid without expiration. Improvement Permit with site plan valid for sixty months. Authorization to Construct is valid for a period equal to that of Improvement Permit – not to exceed sixty months.

Signed: C. [illegible] Agent date 6/1/05 Installed by: Christian Bus

Improvement Permit by: [signature] RS date 6/1/05 Operation Permit by: [signature] RS date 9/8/05

Authorization to Construct by: [signature] RS date 6/1/05 Existing System Inspection by: date

HEALTH DEPT. COPY: WHITE OWNER COPY (FINAL): YELLOW OWNER COPY (INITIAL): PINK