IREDELL COUNTY HEALTH DEPARTMENT

Statesville Phone TR 3-7271 . Mooresville Phone No. 664-5281

PERMIT TO INSTALL SEPTIC TANK

Permit No. 182 Permit Date 7-24-1973

Owner Querry O'donnel Address Mooresville

Installed By Honeycutt Orbison Address Mooresville


Location of Property Isle of Pine off Rd. 1100 to 1113 at end lot 15

Tank		Capacity		Length of Lines		Fixtures	
Block	( )	1000	(✓)	225'	( )	No. of Baths	(2)
Precast	(✓)	1250	( )	250'	( )	Dishwasher	(yes)
		1500	( )	Other 240'		Garbage Grdr.	(yes)
		Other				Other Washing Machine	

NOTIFY HEALTH DEPARTMENT AT LEAST EIGHT HOURS BEFORE TANK IS TO BE INSPECTED.

Final Inspection 7-24-1973 Approved (✓) Disapproved ( )

Remarks

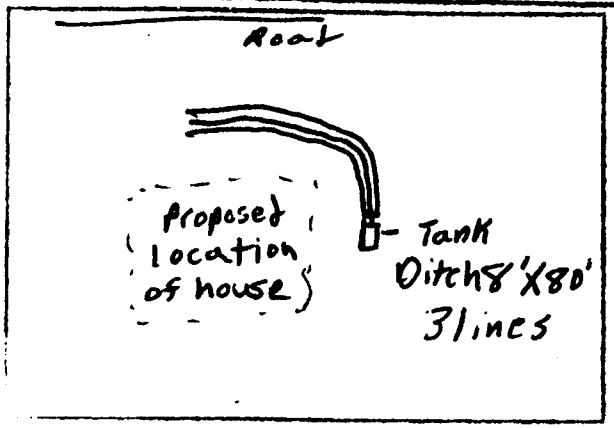

Sketch of Installation

J. C. Moore

Sanitarian