10:30

IREDELL COUNTY HEALTH DEPARTMENT

STATESVILLE 704-878-5305 MOORESVILLE 704-664-5281

IMPROVEMENT PERMIT / AUTHORIZATION TO CONSTRUCT / OPERATION PERMIT / EXISTING SYSTEM INSPECTION

PERMIT# 081556 PIN# 4635460213 DATE 7/1/99

OWNER OR CONTRACTOR Harold Holbrook PHONE: Business 933-2937 Home 933-2949

ADDRESS 204 E. 12th St. Kannapolis, NC 28083

LOCATION Brawley School Rd TL Isle of Pines down towards end 8th lot on left after entering Isle of Pines

SUBDIVISION Isle of Pines BLOCK / SECTION 1 LOT 8 LOT AREA .454 Acre SITE CLASS. PS DESIGN FLOW 360gpd L.T.A.R. .3-.3+

Septic Tank: 1000 Gallons; STB 825 Date 8-11-00
Pump Tank: ____ Gallons; PT ____ Date ____
Pump Make: ____ Model ____ Serial No. ____
Nitrification Field: No Fields 1 Square Feet 900' Linear Feet 300'
No Lines 5@60' Trench Width 36" Max Trench Bottom Depth 36" Gravel Depth N/A


☒ New System ☐ Repair System Type: I, II, (III), IV, V, VI
System Description: Gravity - 25% Reduction
Repair System Description: Partial - Pump Modified
Maintenance Agreement Required: ☐ Yes ☒ No

☒ House/Mod. Home No. Bedrooms 3+
☐ Mobile Home No. Bathrooms 3 (Study)
☐ Business No. Employees ____
☐ Other ____
☐ Slab ☒ Crawl Space ☐ Basement w/plumbing ☐ Basement wo/plumbing

Water Supply: ☒ Individual ☐ Public ☐ Community

Comments:/Conditions: Keep Septic System at least 10' from PL, 5' from House & 50' from any well. Install Septic Tank (ST) in location of former Privy.

Scale 1"=40' INITIAL SITE SKETCH

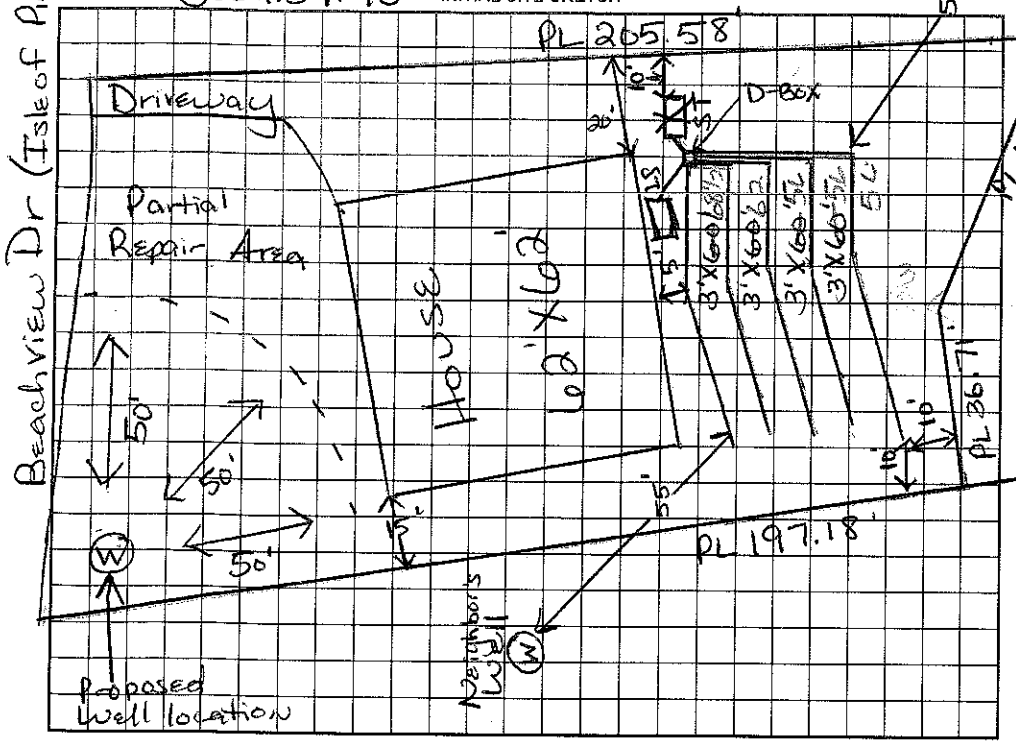

AS BUILT SKETCH

Comments:/Conditions: Lot deeded prior to 1982 - does not have 100% Repair area. Filter installed

12/3/99 740' Contour staked on PL side of pump removed



Permit can be suspended or revoked if any false information is supplied toward securing the permit/any unauthorized changes are made to the site/any unauthorized changes are made in the installation of the system. Improvement Permit with plat valid without expiration. Improvement Permit with site plan valid for sixty months. Authorization to Construct is valid for a period equal to that of Improvement Permit – not to exceed sixty months.

Signed: Harold D. Holbrook date 7-1-99
Improvement Permit by: Maria H. H. Dotson date 7/1/99
Authorization to Construct by: Maria H. H. Dotson date 7/1/99

Installed by: Delbert Bostian
Operation Permit by: Maria H. H. Dotson date 9/29/00
Existing System Inspection by: ____ date ____

HEALTH DEPT. COPY: WHITE OWNER COPY (FINAL): YELLOW OWNER COPY (INITIAL): PINK