IREDELL COUNTY HEALTH DEPARTMENT

Authorization to Construct 4635 460374

TATESVILLE 704-878-5305 MOORESVILLE 704-664-5281

IMPROVEMENT PERMIT / ~~CERTIFICATE OF COMPLETION~~ / OPERATION PERMIT / EXISTING SYSTEM INSPECTION

PROPERTY DESCRIPTION NO. 070061 DATE 11/14/97 TAX MAP NO. 4635460361 +0970 Watershed: [X] Yes [ ] No WS IVCA

OWNER OR CONTRACTOR Dick Wagoner PHONE: Business BEDFORD - 361-1252 Home

ADDRESS 597 Beachview Dr. Mooresville, NC. 28115

LOCATION 599 Isle of Pines Rd. - Bus Sch TL Isle of Pines on (L) past Beachview Ct.

SUBDIVISION Isle of Pines BLOCK / SECTION LOT 6+7 LOT AREA >1 Ac SITE CLASS. PS DESIGN FLOW 360 L.T.A.R. .3

Septic Tank: 1000 Gallons; STB 794 Date 5/29/98

Pump Tank: 1000 Gallons; PT 27 Date 7/9/98

Pump Make: Boulds Model WE05/1H Serial No. 9844649

Nitrification Field: No Fields 1 Square Feet 1200 Linear Feet 400

No Lines 4 Trench Width 36" Max Trench Bottom Depth 36" Gravel Depth 12"

[X] New System [ ] Repair System Type: I, II, (III) IV, V, VI

System Description: PRESMAN - CONVENTIONAL

Repair System Description: SAME

Maintenance Agreement Required: [ ] Yes [X] No

[X] House/Mod. Home No. Bedrooms 3

[ ] Mobile Home No. Bathrooms 3

[ ] Business No. Employees

[ ] Other


[ ] Slab [X] Crawl Space [ ] Basement w/plumbing [ ] Basement wo/plumbing

Water Supply: [X] Individual [ ] Community [ ] Public


Comments: #1 Well must be Properly Abandoned before Operation Permit may be issued -

Comments:

INITIAL SITE SKETCH

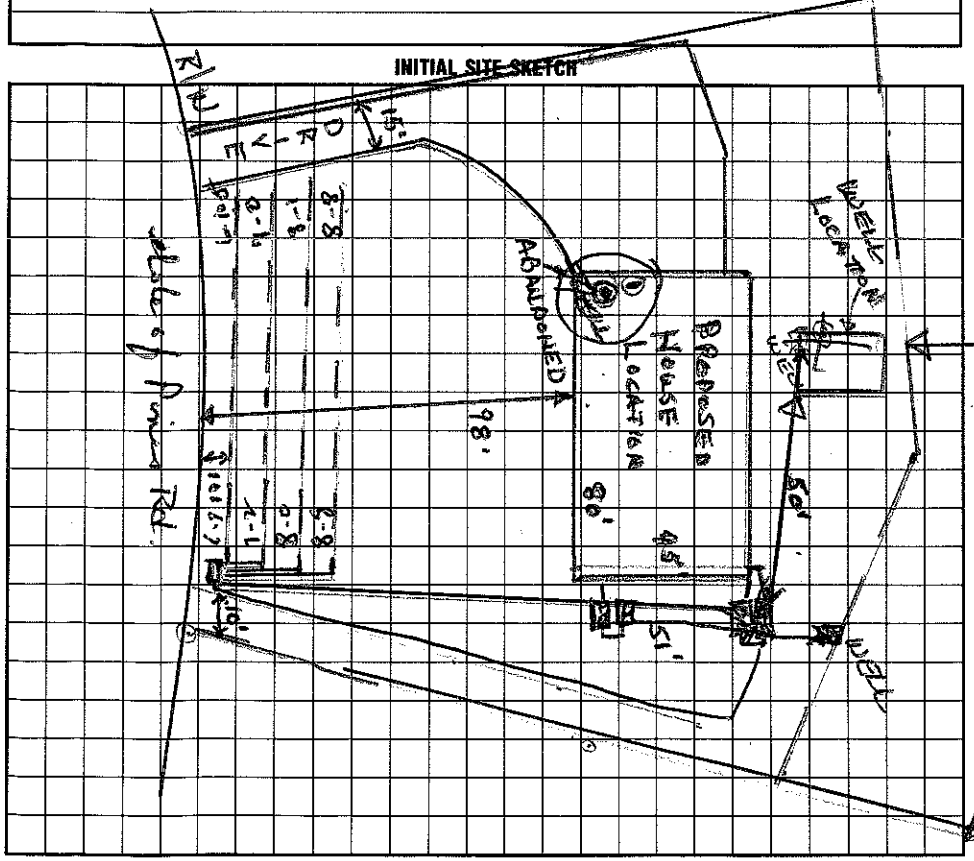

AS BUILT SKETCH

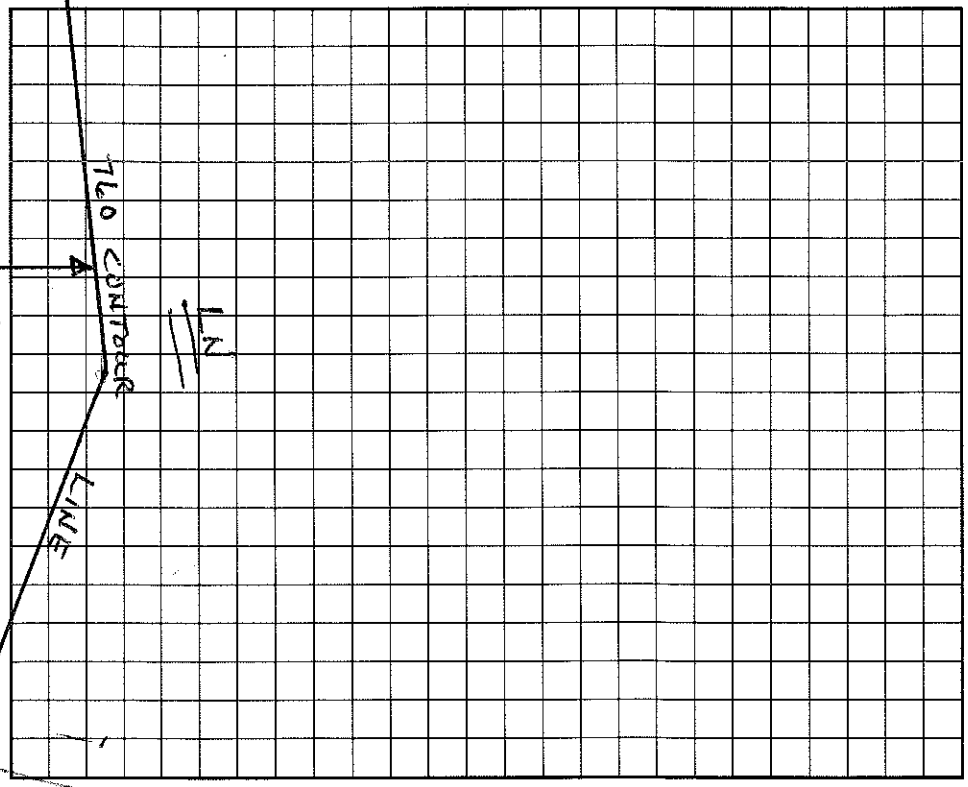

I understand that this permit can be suspended or revoked if any false information is supplied toward securing the permit/any unauthorized changes are made to the site/any unauthorized changes are made in the installation of the system. Improvement Permit is valid for 60 months from date of issuance.

Signed: X Tom Barker Installed by: Chris Hedrick

Improvement Permit by: Wesley Sparks RS. date 11/14/97 Certificate of Completion by: date

Existing System Inspection by: Wesley Sparks RS. date 11/14/97 Operation Permit by: Wesley Sparks RS. date 10/22/98

HEALTH DEPT. COPY: WHITE INSPECTION COPY (FINAL): GREEN OWNER COPY (FINAL): YELLOW INSPECTION COPY (INITIAL): PINK OWNER COPY (INITIAL): GOLD