IREDELL COUNTY HEALTH DEPARTMENT

Statesville Phone TR 3-7271 Mooresville Phone NO 3-1271

PERMIT TO INSTALL SEPTIC TANK

Permit NO. _____ Permit Date 29 March 1967

Owner Mead Lock Address Chad. N.C.

Installed By M.F. Sessoms Address Shelby


Location of Property Bay View East Lot 13

Tank		Capacity		Length of Lines		Fixtures	
Block	( )	1000	(✓)	225'	(✓)	No. of Baths	( )
Precast	(✓)	1250	( )	250'	( )	Dishwasher	( )
		1500	( )	Other _____		Garbage Grdr.	( )
		Other _____				Other _____	

NOTIFY HEALTH DEPARTMENT AT LEAST EIGHT HOURS BEFORE TANK IS TO BE INSPECTED.

Final Inspection 29 March 1967 Approved (✓) Disapproved ( )

Remarks _____

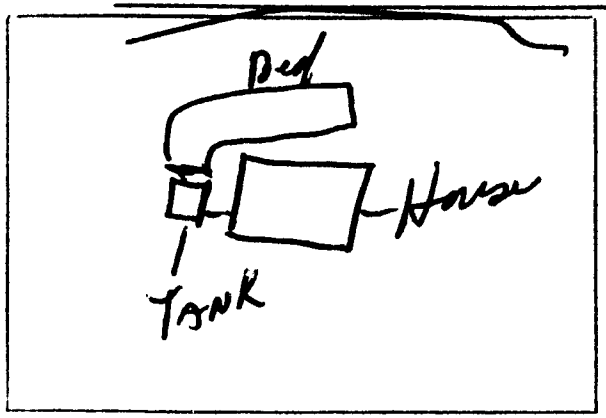

Sketch of Installation

Guy R Sessoms

Sanitarian