IREDELL COUNTY HEALTH DEPARTMENT

Authorization to Construct

STATESVILLE 704-878-5305 MOORESVILLE 704-664-5281

IMPROVEMENT PERMIT / ~~CERTIFICATE OF COMPLETION~~ / OPERATION PERMIT / EXISTING SYSTEM INSPECTION

PROPERTY DESCRIPTION NO. Repair DATE 1/16/96 TAX MAP NO. Repair 4635 48 7348 Watershed: X Yes ☐ No

OWNER OR CONTRACTOR Richard Doncaster PHONE: Business Home 664-7573

ADDRESS 170 Shoreline Lp Mooresville, NC. 28115

LOCATION Stutts TR 1st Shoreline LP TL 1st house on R 360

SUBDIVISION Bay View BLOCK / SECTION LOT 12 LOT AREA .5ac SITE CLASS. PS DESIGN FLOW ~~440~~ L.T.A.R. .35

Septic Tank: Lasty Gallons; STB Date

Pump Tank: 1000 Gallons; PT 27 Date 3/19/97

Pump Make: Goulds Model WE05511H Serial No. 9742319

Nitrification Field: No Fields 1 Square Feet 1600 Linear Feet 250 ±

No Lines 5 Trench Width 24" Max Trench Bottom Depth 36" Gravel Depth 6" SAND-

☐ New System X Repair System Type: I. II. III. IV. V. VI ~~Acad~~ X

System Description: ~~Pump Pumped~~ CHAMBERED

Repair System Description: James Plastic

Maintenance Agreement Required: ☐ Yes ☐ No

☐ Slab ☐ Crawl Space X Basement w/plumbing ☐ Basement wo/plumbing

☐ House/Mod. Home No. Bedrooms ~~4~~ 3

☐ Mobile Home No. Bathrooms 3

☐ Business No. Employees


☐ Other

Water Supply:
X Individual
☐ Community
☐ Public


Comments:
5/5/97 - Changed to Pressure - CH PLASTIC

Comments: Pressure Manifold used & located top left corner facing house — Inspection ports w caps installed

INITIAL SITE SKETCH

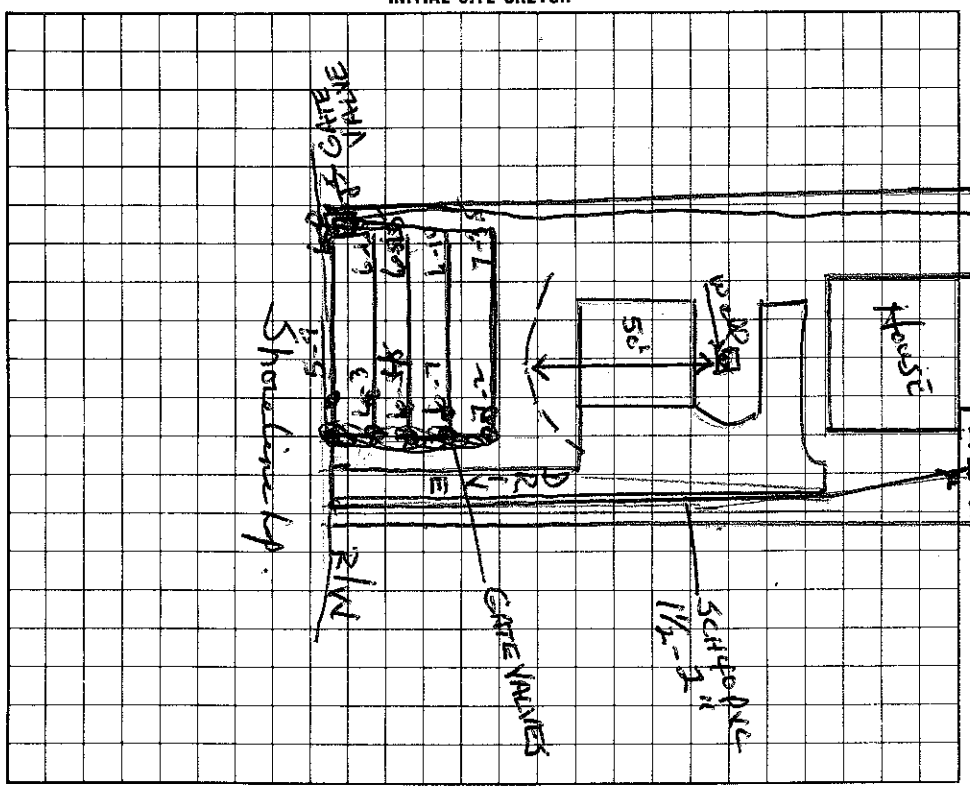

AS BUILT SKETCH

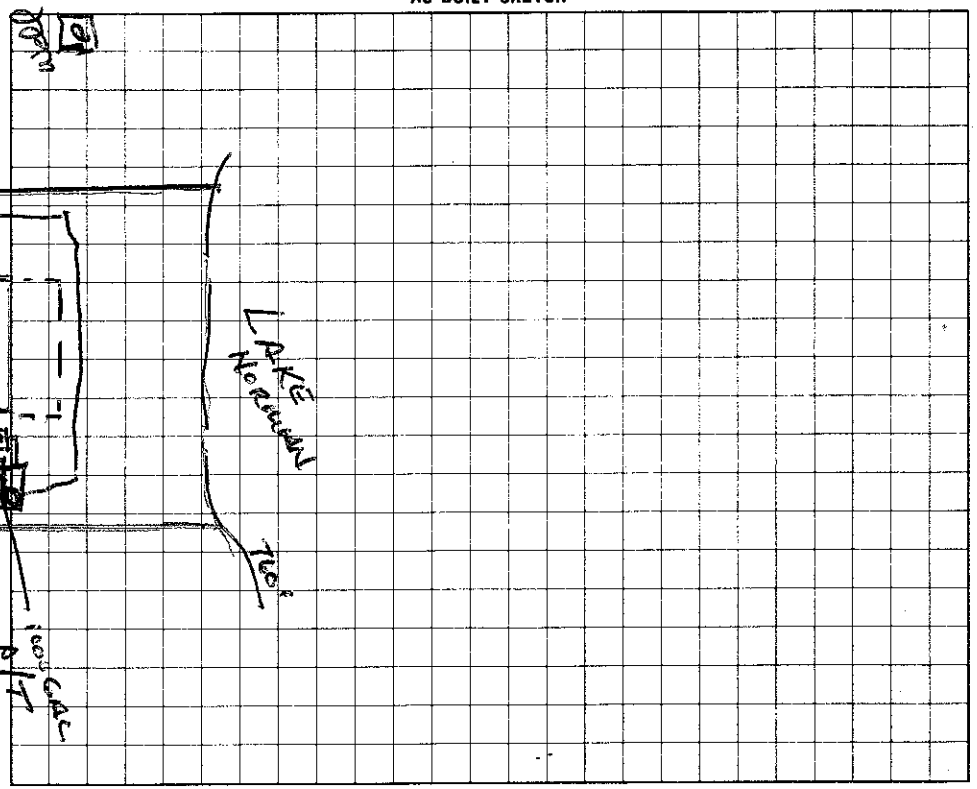

I understand that this permit can be suspended or revoked if any false information is supplied toward securing the permit/any unauthorized changes are made to the site/any unauthorized changes are made in the installation of the system.

Signed:

Improvement Permit by: Wesley Sparks RS. date 1/16/96

Authorization to Construct Existing System Inspection by: Wesley Sparks RS date 1/16/96

Installed by: F J Ervin

Certificate of Completion by: Wesley Sparks RS date 5/8/97

Operation Permit by: Wesley Sparks RS date 5/8/97

HEALTH DEPT. COPY: WHITE INSPECTION COPY (FINAL): GREEN OWNER COPY (FINAL): YELLOW INSPECTION COPY (INITIAL): PINK OWNER COPY (INITIAL): GOLD