4635496178

IREDELL COUNTY HEALTH DEPARTMENT

STATESVILLE 704-878-5305 MOORESVILLE 704-664-5281

IMPROVEMENT PERMIT / CERTIFICATE OF COMPLETION / OPERATION PERMIT / EXISTING SYSTEM INSPECTION

PROPERTY DESCRIPTION NO. 25867 DATE Feb 1, '97 TAX MAP NO. ~~4635496178~~ ~~4635-49-6226~~ Watershed: ☑ Yes ☐ No

OWNER OR CONTRACTOR Ronald Joyner PHONE: Business _____ Home _____

ADDRESS 631 Running Brook Ln. Rural Hall, NC 27045

LOCATION Stubb Rd. TR Boyd Mtch TL Southwood Pkwy ~ ¼ mile on Right

SUBDIVISION Marina Village BLOCK / SECTION _____ LOT 23 LOT AREA 20,100± ft² SITE CLASS. _____ DESIGN FLOW 360 gpd L.T.A.R. _____

Septic Tank: _____ Gallons; STB _____ Date _____

Pump Tank: EXISTING Gallons; PT _____ Date _____

Pump Make: _____ Model _____ Serial No. _____

Nitrification Field: No Fields ____ Square Feet _____ Linear Feet _____

No Lines _____ Trench Width _____ Max Trench Bottom Depth _____ Gravel Depth _____

☐ New System ☐ Repair System Type: I, (II), III, IV, V, VI

System Description: EXISTING

Repair System Description: _____

Maintenance Agreement Required: ☐ Yes ☐ No

☐ House/Mod. Home No. Bedrooms 3

☐ Mobile Home No. Bathrooms 2

☐ Business No. Employees ____

☐ Other _____

☐ Slab ☐ Crawl Space ☐ Basement w/plumbing ☐ Basement wo/plumbing

Water Supply: ☑ Individual ☐ Community ☐ Public


Comments: No sign of septic system malfunction

Addition to house of garage, study, kitchen, dining area

No increase in total bedrooms

Comments:

INITIAL SITE SKETCH

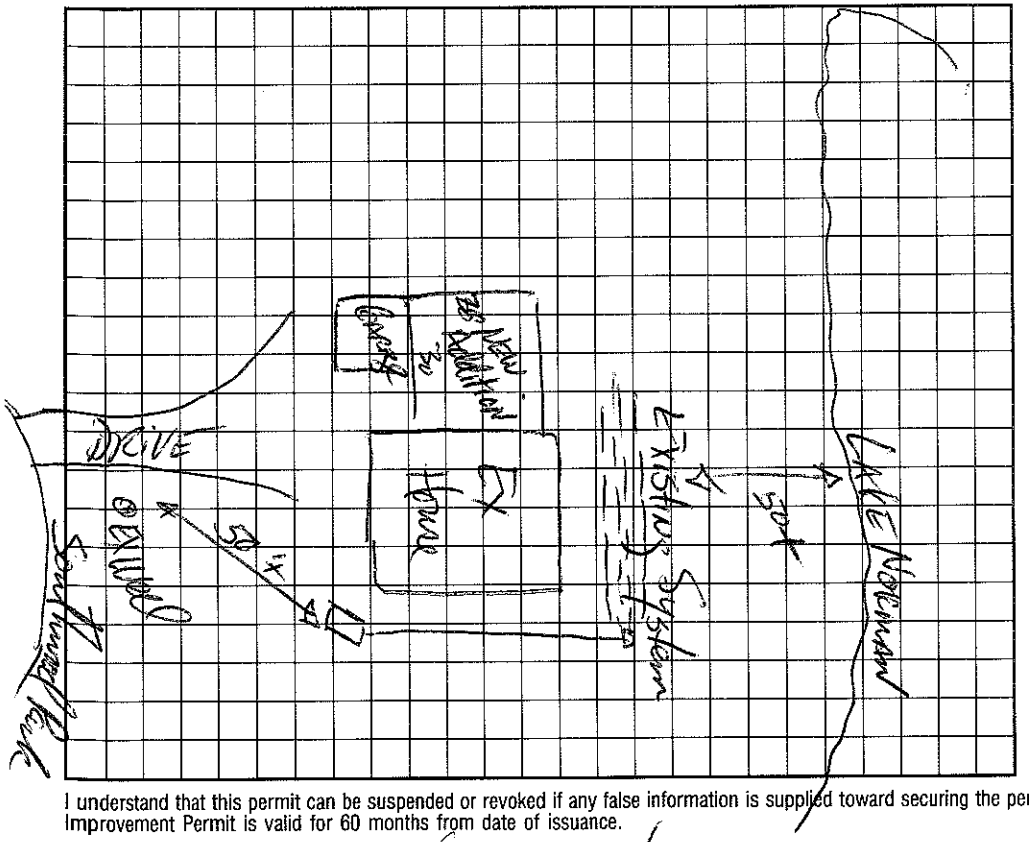

AS BUILT SKETCH

I understand that this permit can be suspended or revoked if any false information is supplied toward securing the permit/any unauthorized changes are made to the site/any unauthorized changes are made in the installation of the system. Improvement Permit is valid for 60 months from date of issuance.

Signed: _____

Improvement Permit by: _____ date _____

Existing System Inspection by: _____ date 2-1-97

Installed by: _____

Certificate of Completion by: _____ date _____

Operation Permit by: _____ date _____

HEALTH DEPT. COPY: WHITE INSPECTION COPY (FINAL): GREEN OWNER COPY (FINAL): YELLOW INSPECTION COPY (INITIAL): PINK OWNER COPY (INITIAL): GOLD