IREDELL COUNTY HEALTH DEPARTMENT

STATESVILLE 704-878-5305 — MOORESVILLE 704-664-5281

IMPROVEMENT PERMIT / AUTHORIZATION TO CONSTRUCT / OPERATION PERMIT / EXISTING SYSTEM INSPECTION

PERMIT# 112776 PIN# 4635 49 7162 DATE 9/22/03

OWNER OR CONTRACTOR Alan S Campbell PHONE: Business 704-367-0113 Home

ADDRESS 3509 Castellaine Dr. Charlotte, NC. 28216

LOCATION 1100 Tl Stutts (R) Southwood Park Rd. property on (L) in curve

SUBDIVISION Marina Village BLOCK / SECTION LOT 24 LOT AREA .52 Ac SITE CLASS. DESIGN FLOW 240 L.T.A.R. 2

Septic Tank: EXISTING Gallons: STB Date

Pump Tank: Gallons: PT Date

Pump Make: Model Serial No.

Nitrification Field: No Fields Square Feet ~~Square Feet~~ linear Feet

No Lines Trench Width Max Trench Bottom Depth Gravel Depth

☐ New System ☐ Repair System Type: I (II) III, IV, V, VI

System Description: Existing System.

Repair System Description:

Maintenance Agreement Required: ☐ Yes ☐ No

☒ House/Mod. Home No. Bedrooms X1

☐ Mobile Home No. Bathrooms 1

☐ Business No. Employees

☐ Other


☐ Slab ☐ Crawl Space ☐ Basement w/plumbing ☐ Basement wo/plumbing

Water Supply:
☒ Individual
☐ Public
☐ Community

Comments:/Conditions:

Comments:/Conditions: X 240GPD IS THE MINIMUM SIZE FOR A RESIDENTIAL SEPTIC SYSTEM THIS EQUATES TO 2 TWO BEDROOMS USAGE. AWS 2/16/2014

INITIAL SITE SKETCH

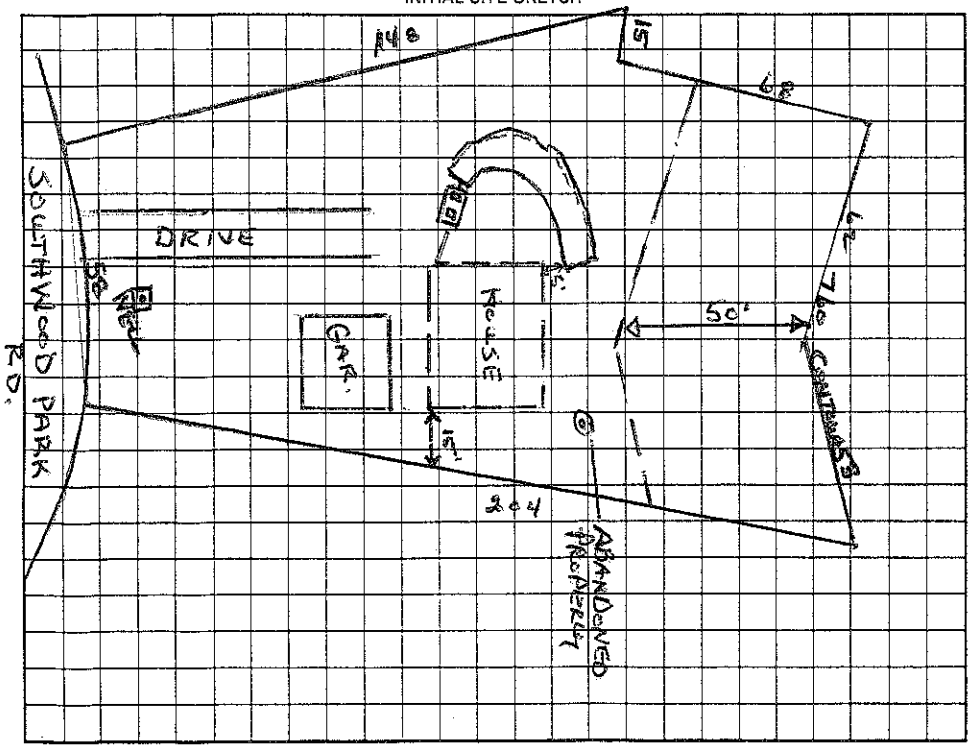

AS BUILT SKETCH

Permit can be suspended or revoked if any false information is supplied toward securing the permit/any unauthorized changes are made to the site/any unauthorized changes are made in the installation of the system. Improvement Permit with plat valid without expiration. Improvement Permit with site plan valid for sixty months. Authorization to Construct is valid for a period equal to that of Improvement Permit – not to exceed sixty months.

Signed: X Alan S. Campbell date 9/23/03 Installed by:

Improvement Permit by: date Operation Permit by: date

Authorization to Construct by: date Existing System Inspection by: Wesley Sparks RS. date 9/22/03

HEALTH DEPT. COPY: WHITE OWNER COPY (FINAL): YELLOW OWNER COPY (INITIAL): PINK