IREDELL COUNTY HEALTH DEPARTMENT

STATESVILLE 704-878-5305 MOORESVILLE 704-664-5281

130.00 Paid 4108499269

IMPROVEMENT PERMIT / AUTHORIZATION TO CONSTRUCT / OPERATION PERMIT / EXISTING SYSTEM INSPECTION

PERMIT# 126 224 PIN# 4635 49 9417 DATE 3/8/05

OWNER OR CONTRACTOR Carol Helms / Michelle Cole PHONE: Business — Home 704 278 3215

ADDRESS 895 Cal Kennedy Rd Cleveland, NC 27013

LOCATION BSR, TL Stutts, TR Southwood, TR Crescent on Rt [illegible] Southwood Park dr

SUBDIVISION Marina Village BLOCK / SECTION — LOT 3 LOT AREA 0.467c SITE CLASS PS DESIGN FLOW 360 L.T.A.R. 0.3

Septic Tank: 1000 Gallons; STB 1007 Date 6-16-06
Pump Tank: — Gallons; PT — Date —
Pump Make: — Model — Serial No. —
Nitrification Field: No Fields 1 Square Feet 900 Linear Feet 300
No Lines 4 Trench Width 36" Max Trench Bottom Depth 36" Gravel Depth —


☒ New System ☐ Repair System Type: I, II, III, IV, V, VI
System Description: Gravity 25% Reduction
Repair System Description: Same LPPPBPS
Maintenance Agreement Required: ☐ Yes ☒ No

☒ House/Mod. Home No. Bedrooms 3
☐ Mobile Home No. Bathrooms —
☐ Business No. Employees —
☐ Other —
☐ Slab ☒ Crawl Space ☐ Basement w/plumbing ☐ Basement wo/plumbing

Water Supply: ☒ Individual ☐ Public ☐ Community


Comments:/Conditions: Property lines changed - Must have 100% Repair Area
1"=40' * Switch Initial + Repair * New Repair may need to be pumped

INITIAL SITE SKETCH

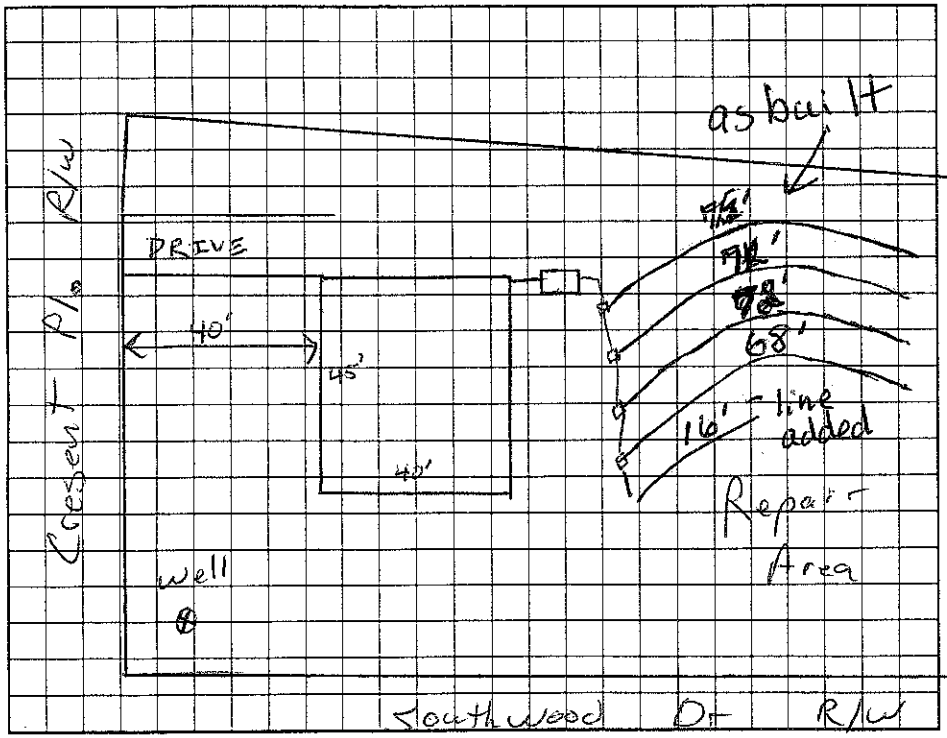

Comments:/Conditions: House w/ basement w/plumbing
House 56' Depth - violates permit for size 42' width + foundation - fee paid $350
Gary McNeely gave permission to put lines in off contour.

AS BUILT SKETCH

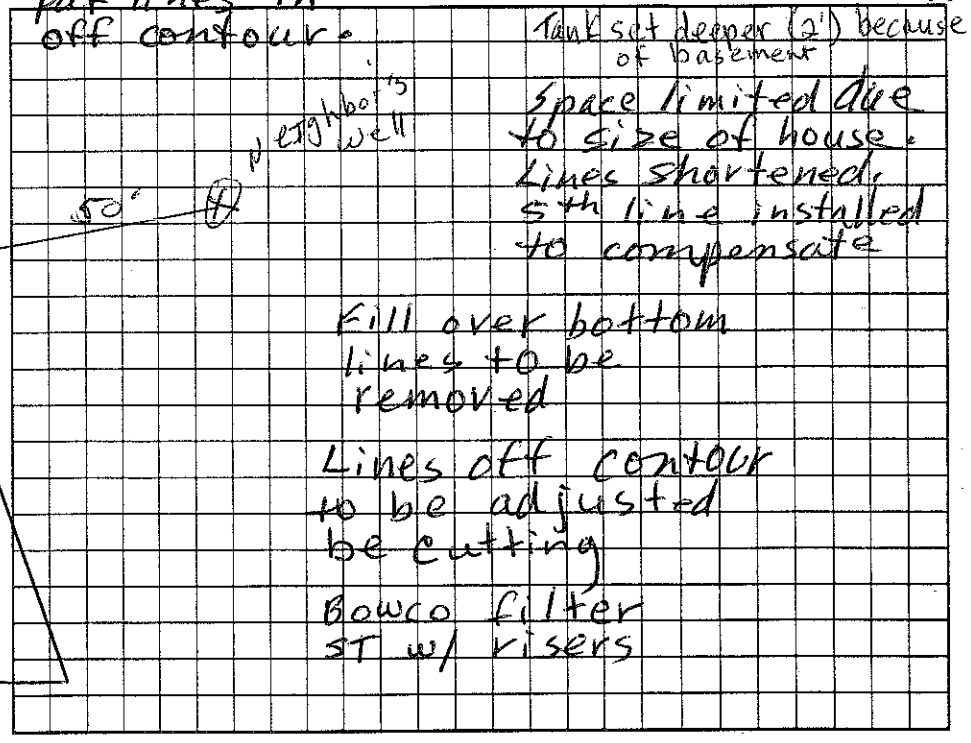

Permit can be suspended or revoked if any false information is supplied toward securing the permit/any unauthorized changes are made to the site/any unauthorized changes are made in the installation of the system. Improvement Permit with plat valid without expiration. Improvement Permit with site plan valid for sixty months. Authorization to Construct is valid for a period equal to that of Improvement Permit – not to exceed sixty months.

Signed: [signature] date 3/29/05 Installed by: BGI Grading - Brad Johnson

Improvement Permit by: [signature] RS date 3/8/05 Operation Permit by: Judy Mitchell date 10-17-06

Authorization to Construct by: [signature] RS date 12/8/05 Existing System Inspection by: — date —

HEALTH DEPT. COPY: WHITE OWNER COPY (FINAL): YELLOW OWNER COPY (INITIAL): PINK