IREDELL COUNTY HEALTH DEPARTMENT

Statesville Phone TR 3-7271 Mooresville Phone NO 3-1271

PERMIT TO INSTALL SEPTIC TANK

Permit NO. _____ Permit Date 16 Jan 1970

Owner Stevenson Address Charlotte

Installed By Honeycutt Orbison Address Mooresville


Location of Property Imperial Pt. Lot # 8

Tank		Capacity		Length of Lines		Fixtures	
Block	( )	1000	(-)	225'	(-)	No. of Baths	( )
Precast	(✓)	1250	( )	250'	( )	Dishwasher	( )
		1500	( )	Other _____		Garbage Grdr.	( )
		Other _____				Other _____	

NOTIFY HEALTH DEPARTMENT AT LEAST EIGHT HOURS BEFORE TANK IS TO BE INSPECTED.

Final Inspection 16 Jan 1970 Approved (✓) Disapproved ( )

Remarks Water From Well Pool

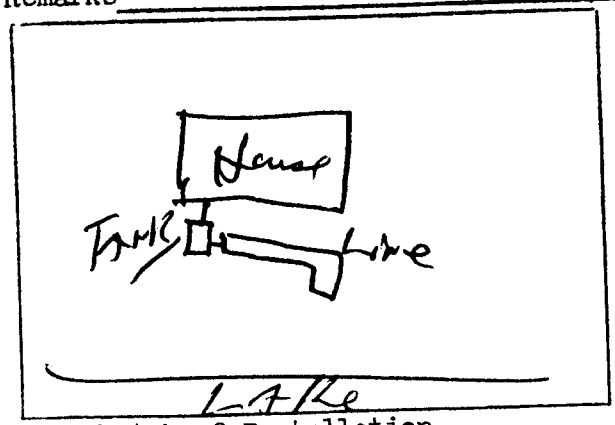

Sketch of Installation

Troy Scoggin

Sanitarian