IREDELL COUNTY HEALTH DEPARTMENT

STATESVILLE 704-878-5305 MOORESVILLE 704-664-5281

IMPROVEMENT PERMIT / AUTHORIZATION TO CONSTRUCT / OPERATION PERMIT / EXISTING SYSTEM INSPECTI

PERMIT# 075291 PIN# 4635564998 DATE 7/5/02

OWNER OR CONTRACTOR CAMPAGNA HOMES INC PHONE: Business 704-634-1155 Home

ADDRESS 1227 KENSINGTON LN SALISBURY NC 28146

LOCATION BRAWLEY SCHOOL - TL STUTTS - TR SHORELINE LOOP - IN CURVE ACROSS FROM # 258

SUBDIVISION IMPERIAL POINT BLOCK / SECTION LOT 25 LOT AREA SITE CLASS. PS DESIGN FLOW 360/0 L.T.A.R. 300/150

Septic Tank: 1000 Gallons; STB 825 Date 10/10/02
Pump Tank: Gallons; PT Date
Pump Make: Model Serial No.
Nitrification Field: No Fields 1 Square Feet 400 Linear Feet 200
No Lines 4@50' Trench Width 24" Max Trench Bottom Depth 36" Gravel Depth N/A

☑ New System ☐ Repair System Type: I, II, III, IV, V, VI
System Description: GRAVITY PANEL
Repair System Description: LP PANEL/NEEDED BEFORE
Maintenance Agreement Required: ☐ Yes ☑ No 1983


☑ House/Mod. Home No. Bedrooms 3
☐ Mobile Home No. Bathrooms 3
☐ Business No. Employees
☐ Other
☐ Slab ☑ Crawl Space ☐ Basement w/plumbing ☐ Basement wo/plumbing

Water Supply: ☑ Individual ☐ Public ☐ Community

Comments:/Conditions:
1) SEE ATTACHED DEED FOR DATE RECORDED (1976)

Comments:/Conditions:

INITIAL SITE SKETCH 1" = 40'

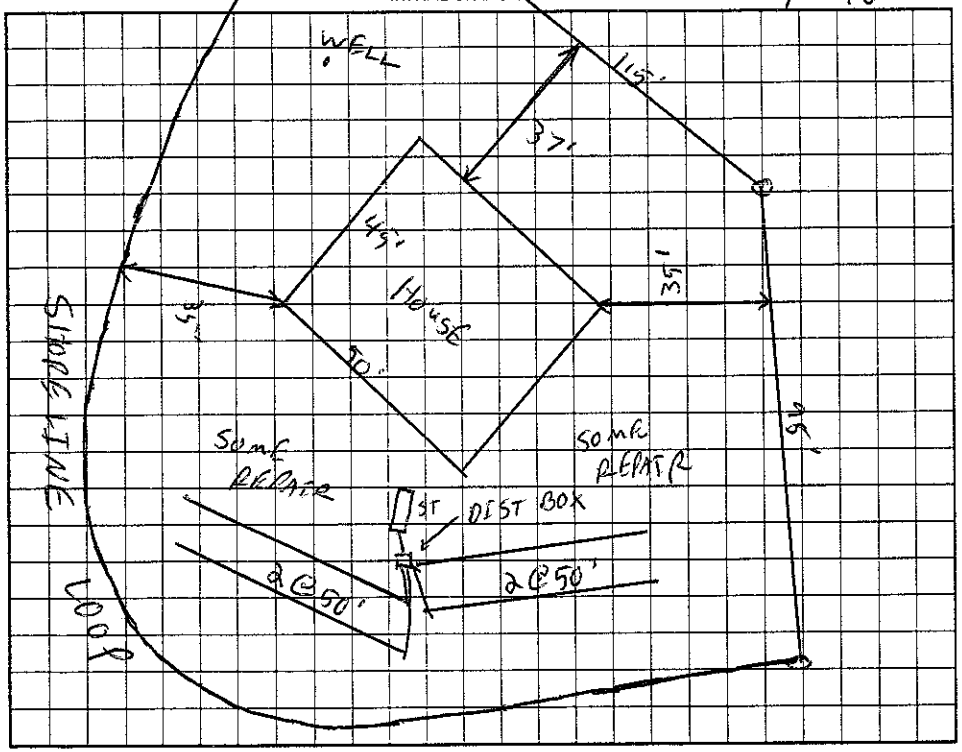

AS BUILT SKETCH

Installed As Drawn

Permit can be suspended or revoked if any false information is supplied toward securing the permit/any unauthorized changes are made to the site/any unauthorized changes are made in the installation of the system. Improvement Permit with plat valid without expiration. Improvement Permit with site plan valid for sixty months. Authorization to Construct is valid for a period equal to that of Improvement Permit – not to exceed sixty months.

Signed: Neil Campagna date 7/8/02 Installed by: Rowan Septic

Improvement Permit by: RS date 7/5/02 Operation Permit by: RS date 1/2/03

Authorization to Construct by: RS date 7/5/02 Existing System Inspection by: date

HEALTH DEPT. COPY: WHITE OWNER COPY (FINAL): YELLOW OWNER COPY (INITIAL): PINK