IREDELL COUNTY HEALTH DEPARTMENT

STATESVILLE 704-878-5305 MOORESVILLE 704-664-5281

IMPROVEMENT PERMIT / CERTIFICATE OF COMPLETION / OPERATION PERMIT / EXISTING SYSTEM INSPECTION

PROPERTY DESCRIPTION NO. 19594 DATE 10/26/94 TAX MAP NO. 26-14-A-15 Watershed: ☐ Yes ☑ No

OWNER OR CONTRACTOR Joseph Zastrow ~~PHONE: Business~~ 4635-56-7860 Home

ADDRESS Rt 9 Box 8160 Mooresville, NC. 28115

LOCATION Shirley's Rd, Trailer end of, 1 mile on ⓒ # 266 Shorelinehoop.

SUBDIVISION Rapunel Point BLOCK / SECTION LOT 13 LOT AREA Existing SITE CLASS. DESIGN FLOW 360 L.T.A.R.

Septic Tank: Existing Gallons; STB Date

Pump Tank: Gallons; PT Date

Pump Make: Model Serial No.

Nitrification Field: No Fields Square Feet Existing Linear Feet

No Lines Trench Width Max Trench Bottom Depth Gravel Depth

☐ New System ☐ Repair System Type: I (II) III, IV, V, VI

System Description: Existing System

Repair System Description:

Maintenance Agreement Required: ☐ Yes ☑ No

☑ House/Mod. Home No. Bedrooms 3

☐ Mobile Home No. Bathrooms 2

☐ Business No. Employees

☐ Other


☐ Slab ☐ Crawl Space ☐ Basement w/plumbing ☐ Basement wo/plumbing

Water Supply:
☑ Individual
☐ Community
☐ Public

Comments:

Comments:

~~INITIAL SITE SKETCH~~ AS BUILT SKETCH

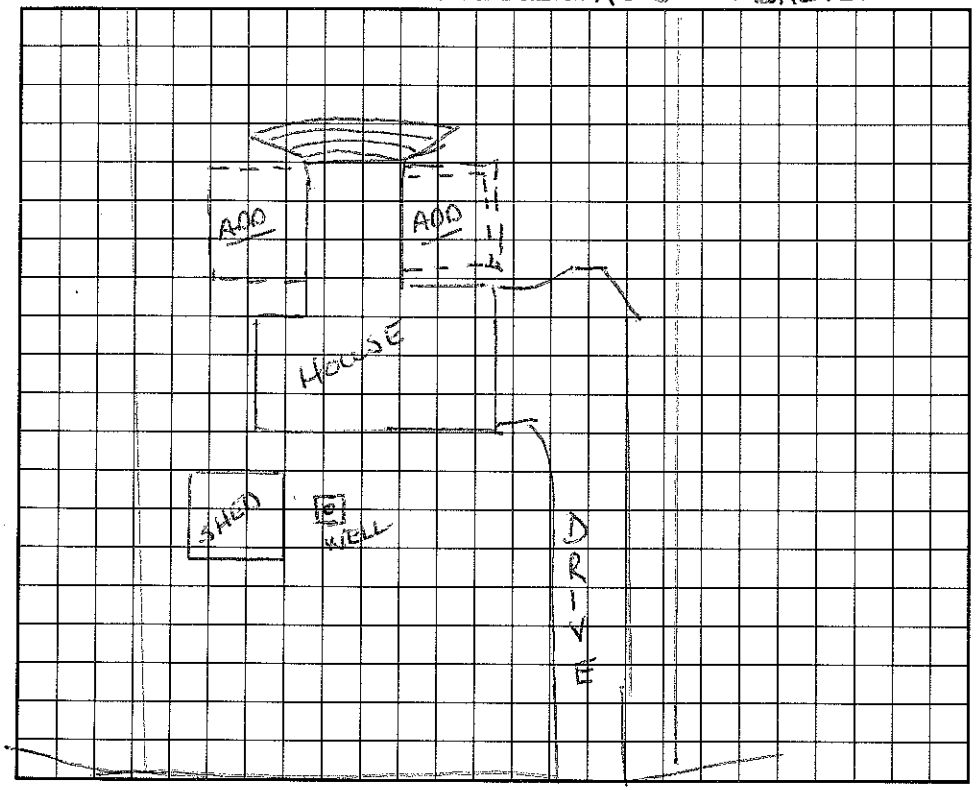

AS BUILT SKETCH

I understand that this permit can be suspended or revoked if any false information is supplied toward securing the permit/any unauthorized changes are made to the site/any unauthorized changes are made in the installation of the system. Improvement Permit is valid for 60 months from date of issuance.

SHORELINE LP.

Signed:

Installed by:

Improvement Permit by: date

Certificate of Completion by: date

Existing System Inspection by: Wesley Sparks RS date 10/26/94

Operation Permit by: date

HEALTH DEPT. COPY: WHITE INSPECTION COPY (FINAL): GREEN OWNER COPY (FINAL): YELLOW INSPECTION COPY (INITIAL): PINK OWNER COPY (INITIAL): GOLD