IREDELL COUNTY HEALTH DEPARTMENT

STATESVILLE 704-878-5305 MOORESVILLE 704-664-5281

IMPROVEMENT PERMIT / CERTIFICATE OF COMPLETION / OPERATION PERMIT / EXISTING SYSTEM INSPECTION

PROPERTY DESCRIPTION NO. 17922 DATE March 11, '94 TAX MAP NO. 26-14A5 Watershed: ☑ Yes ☐ No

OWNER OR CONTRACTOR Brad & Susan Boyer PHONE~~Business~~ 4635-57-2012 Home 664-4880 LN

ADDRESS 404 W. Wilson Ave, Mooresville, NC

LOCATION 1160 to 1112 to end Bear Right on Shoreline Loop ½-¾ mile on left

SUBDIVISION Compass Point BLOCK / SECTION LOT 5 LOT AREA 20,000ft² SITE CLASS. 55 pu. 1952 DESIGN FLOW 440 gpd L/T A.R. .3-.4


Septic Tank: 1000 Gallons; STB 794 Ditlugo Date 11-9-95	☑ New System ☐ Repair System Type: I, II, III, IV, V, VI	☑ House/Mod. Home	No. Bedrooms 4	Water Supply:
Pump Tank: ____ Gallons; PT ____ Date ____	System Description: gravity PPBRS	☐ Mobile Home	No. Bathrooms 3½	☑ Individual
Pump Make: ____ Model ____ Serial No. ____	Repair System Description: √ Same	☐ Business	No. Employees ____	☐ Community
Nitrification Field: No Fields 2 Square Feet ____ Linear Feet 270	Maintenance Agreement Required: ☐ Yes ☐ No	☐ Other ____		☐ Public
No Lines 3+3 Trench Width 24" Max Trench Bottom Depth 36" Gravel Depth NA	☐ Slab ☑ Crawl Space ☐ Basement w/plumbing ☐ Basement wo/plumbing			

Comments: Exit plumbing near existing grade to accomodate specified trench bottom depth


9/8/95 OK to use 400 s.f. Infiltration (270@100) DKH

Comments: 364 s.f. infiltration installed

INITIAL SITE SKETCH

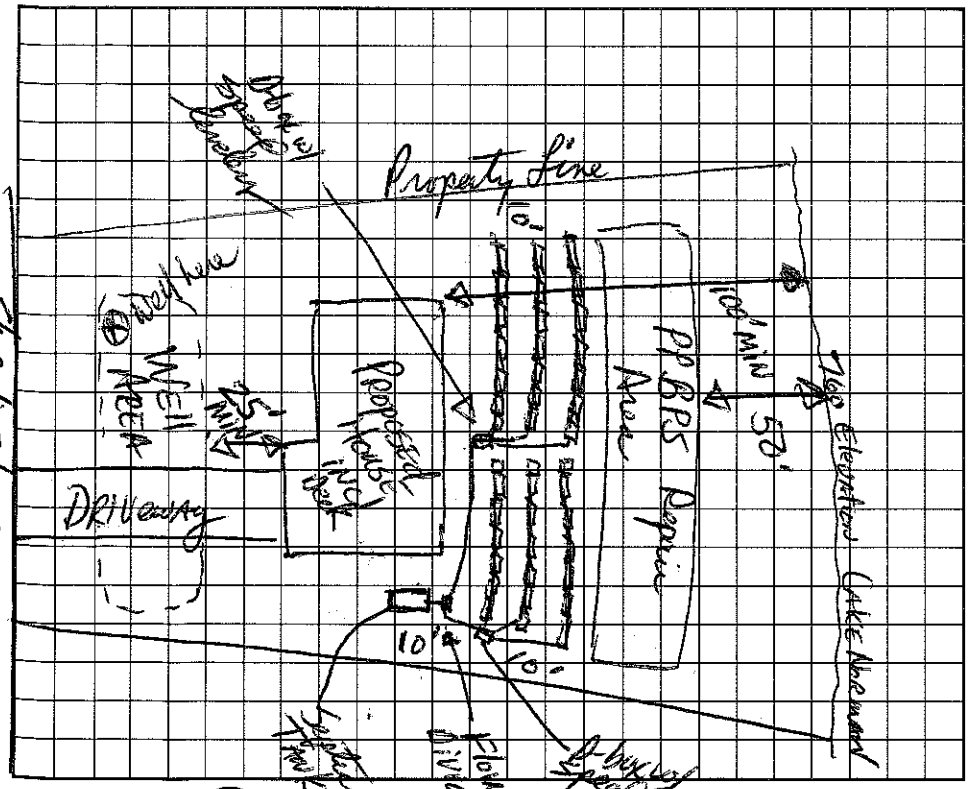

AS BUILT SKETCH

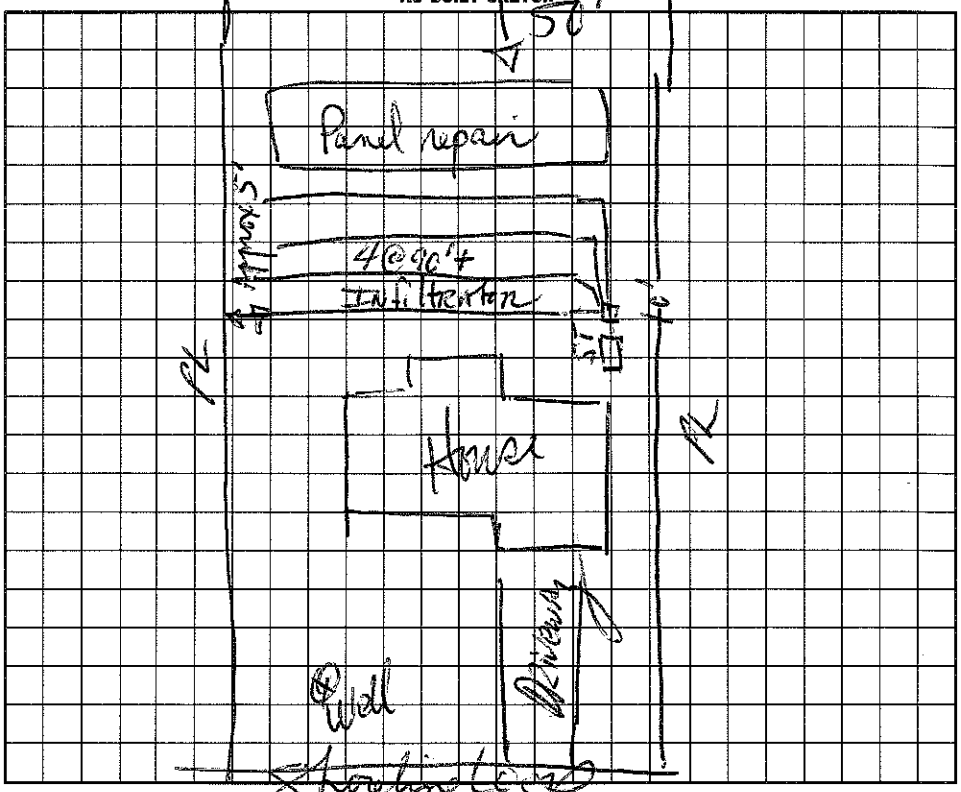

I understand that this permit can be suspended or revoked if any false information is supplied toward securing the permit/any unauthorized changes are made to the site/any unauthorized changes are made in the installation of the system. Improvement Permit is valid for 60 months from date of issuance.

Signed: Brad Boyer 3/11/94

Improvement Permit by: David R Hunter, RS date 3/11/94

Existing System Inspection by: ____ date ____

Installed by: T J Ervin

Certificate of Completion by: ____ date ____

Operation Permit by: D R Hunter, RS date 12-5-95

HEALTH DEPT. COPY: WHITE INSPECTION COPY (FINAL): GREEN OWNER COPY (FINAL): YELLOW INSPECTION COPY (INITIAL): PINK OWNER COPY (INITIAL): GOLD