4635573429

IREDELL COUNTY HEALTH DEPARTMENT

STATESVILLE 704-878-5305 MOORESVILLE 704-664-5281

IMPROVEMENT PERMIT / CERTIFICATE OF COMPLETION / OPERATION PERMIT / EXISTING SYSTEM INSPECTION

PROPERTY DESCRIPTION NO. Repair DATE _____ TAX MAP NO. Repair Watershed: ☑ Yes ☐ No

OWNER OR CONTRACTOR JOHNNIE BENFIELD PHONE: Business _____ Home _____

ADDRESS 217 SHORELINE LOOP

LOCATION BRAWLEY SCHOOL RD - TL SMITH RD - TR SHORELINE LOOP - ~~LFT~~ ON RT

SUBDIVISION _____ BLOCK / SECTION _____ LOT _____ LOT AREA _____ SITE CLASS. _____ DESIGN FLOW _____ L.T.A.R. _____

Septic Tank: 1000 Gallons; STB _____ Date _____

Pump Tank: _____ Gallons; PT _____ Date _____

Pump Make: _____ Model _____ Serial No. _____

Nitrification Field: No Fields 1 Square Feet 404 Linear Feet 98'

No Lines 1 BED Trench Width AS NEEDED Max Trench Bottom Depth AS NEEDED Gravel Depth 2 1/2"

☑ New System ☐ Repair System Type: I, II, III, IV, V, VI

System Description: GRAVITY CONVENTION - BALL RUN VALVE

Repair System Description: _____

Maintenance Agreement Required: ☐ Yes ☑ No

☑ House/Mod. Home No. Bedrooms 3

☐ Mobile Home No. Bathrooms 2

☐ Business No. Employees _____

☐ Other _____


☐ Slab ☐ Crawl Space ☑ Basement w/plumbing ☐ Basement wo/plumbing

Water Supply: ☑ Individual ☐ Community ☐ Public

Comments: 6-8" SAND ADDED FOR TREATMENT OF EFFLUENT.

Comments:

INITIAL SITE SKETCH

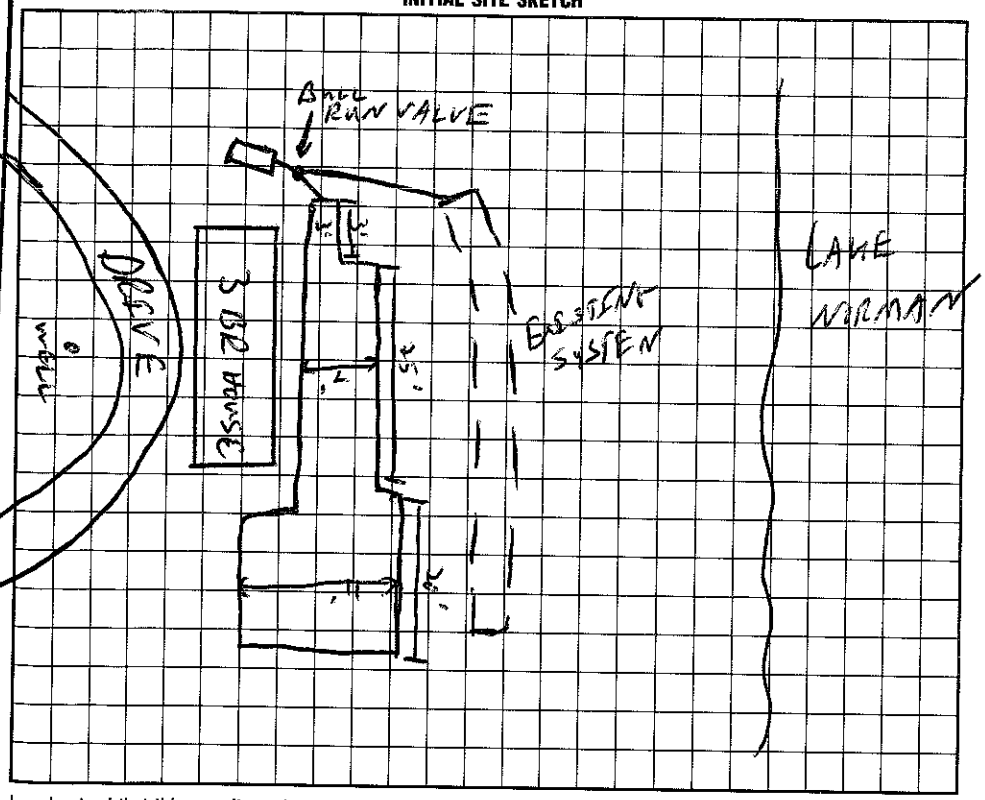

AS BUILT SKETCH

I understand that this permit can be suspended or revoked if any false information is supplied toward securing the permit/any unauthorized changes are made to the site/any unauthorized changes are made in the installation of the system. Improvement Permit is valid for 60 months from date of issuance.

Signed: Richard Abernathy Installed by: RICHARD ABERNATHY

Improvement Permit by: C. Hughes date _____ Certificate of Completion by: _____ date _____

Existing System Inspection by: C. Hughes date _____ Operation Permit by: C. Hughes date 5/6/97

HEALTH DEPT. COPY: WHITE INSPECTION COPY (FINAL): GREEN OWNER COPY (FINAL): YELLOW INSPECTION COPY (INITIAL): PINK OWNER COPY (INITIAL): GOLD

C. HUGHES 1 NO