IREDELL COUNTY HEALTH DEPARTMENT

STATESVILLE 704-878-5305 50.00 Paid MOORESVILLE 704-664-5281 400

IMPROVEMENT PERMIT / AUTHORIZATION TO CONSTRUCT / OPERATION PERMIT / EXISTING SYSTEM INSPECTION

PERMIT# 12725 088059 PIN# 4635 57 3738 DATE 5/1/03

OWNER OR CONTRACTOR CAMPAGNA HOMES INC / OHANNESYAN PHONE: Business 704-634-1185 Home

ADDRESS 278 SHORELINE LOOP MOORESVILLE NC. 28117

LOCATION 1100 L STUTTS (R) SHORELINE LOOP LOT ON LEFT

SUBDIVISION BAYVIEW ESTATES BLOCK / SECTION LOT 26 LOT AREA ~20,000 FT² SITE CLASS. PS DESIGN FLOW 240 L.T.A.R. .25

Septic Tank: 1000 Gallons; STB 825 Date 5/22/03
Pump Tank: 1000 Gallons; PT 30V Date 3/18/03
Pump Make: ZOELLER Model N-98B Serial No. 7/15/03
Nitrification Field: No Fields 1 Square Feet 600 Linear Feet 200
No Lines 4 @ 50' Trench Width 2-3' Max Trench Bottom Depth 30" Gravel Depth SAND

[X] New System [ ] Repair System Type: I, II, III, (IV) V, VI
System Description: LPP - 16" PPBPS
Repair System Description: "NONE" < 1983
Maintenance Agreement Required: [X] Yes [ ] No

[X] House/Mod. Home No. Bedrooms 3
[ ] Mobile Home No. Bathrooms 2
[ ] Business No. Employees
[ ] Other
[ ] Slab [X] Crawl Space [ ] Basement w/plumbing [ ] Basement wo/plumbing


Water Supply: [X] Individual [ ] Public [ ] Community

Comments:/Conditions:

Comments:/Conditions: TANKS, PRESSURE, LINES

(1"=40')

INITIAL SITE SKETCH

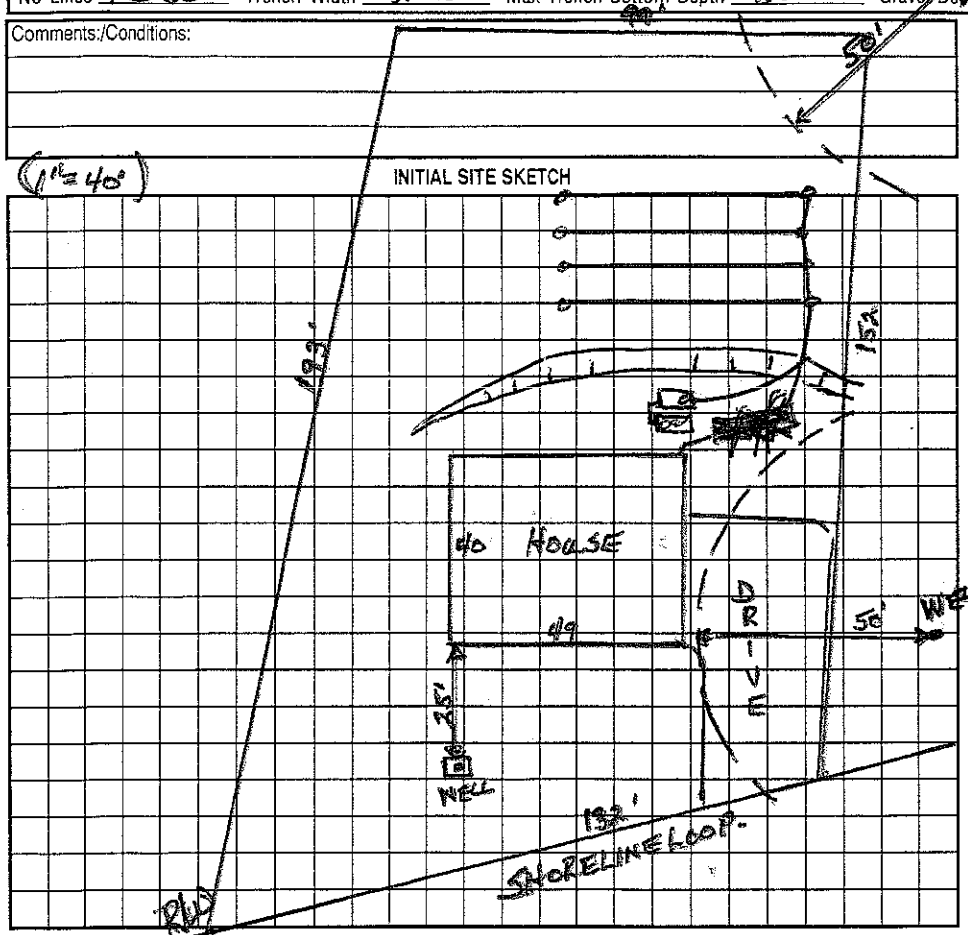

AS BUILT SKETCH

Permit can be suspended or revoked if any false information is supplied toward securing the permit/any unauthorized changes are made to the site/any unauthorized changes are made in the installation of the system. Improvement Permit with plat valid without expiration. Improvement Permit with site plan valid for sixty months. Authorization to Construct is valid for a period equal to that of Improvement Permit – not to exceed sixty months.

Signed: * Neil Campagna date 5/5/03

Improvement Permit by: Wesley Sparks RS. date 5/1/03

Authorization to Construct by: Wesley Sparks RS date 5/1/03

Installed by: Rowan Septic Tank

Operation Permit by: Wesley Sparks RS date 11/17/03

Existing System Inspection by: date

HEALTH DEPT. COPY: WHITE OWNER COPY (FINAL): YELLOW OWNER COPY (INITIAL): PINK