IREDELL COUNTY HEALTH DEPARTMENT

STATESVILLE 704-878-5305 175.01 Paid MOORESVILLE 704-664-5281

IMPROVEMENT PERMIT / AUTHORIZATION TO CONSTRUCT / OPERATION PERMIT / EXISTING SYSTEM INSPECTION

PERMIT# 094869 PIN# 4635575224 DATE 6-8-2001

OWNER OR CONTRACTOR Campagna Homes PHONE: Business 634-1185 Home

ADDRESS 1227 Kensington Ln. Salisbury NC 28146

LOCATION Brawley School Rd TL Stutts TR Shoreline on right (midway down)

SUBDIVISION Imperial Pt. BLOCK / SECTION LOT 23 LOT AREA .5 Acre SITE CLASS. PS DESIGN FLOW 360gpd L.T.A.R. .3

Septic Tank: 1000 Gallons; STB 825 Date 5/28/01
Pump Tank: Gallons; PT Date
Pump Make: Model Serial No.
Nitrification Field: No Fields 1 Square Feet 900' Linear Feet 300'
No Lines 4@75' Trench Width 36" Max Trench Bottom Depth 36" Gravel Depth N/A

☒ New System ☐ Repair System Type: I II III IV V VI
System Description: Gravity - 25% Reduction
Repair System Description: Partial - Innovative
Maintenance Agreement Required: ☐ Yes ☒ No

☒ House/Mod. Home No. Bedrooms 3
☐ Mobile Home No. Bathrooms 2
☐ Business No. Employees
☐ Other


☐ Slab ☒ Crawl Space ☐ Basement w/plumbing ☐ Basement wo/plumbing

Water Supply: ☒ Individual ☐ Public ☐ Community

Comments:/Conditions: Keep Septic System at least 10' From PL & 50' from any well. Well must be at least 25' from house & 50' from Septic.


Comments:/Conditions: * Lot platted prior to 1983 - partial drainfield repair area

INITIAL SITE SKETCH Scale 1:40

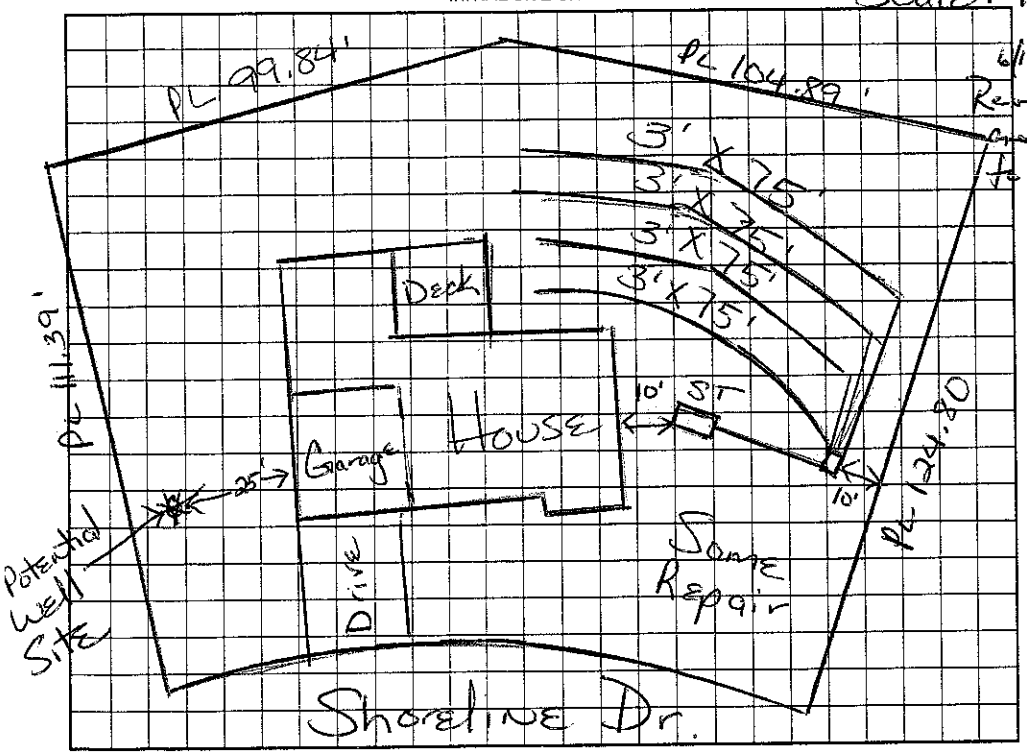

6/14/01 Reviewed plans and they conform to permit requirements BWS

AS BUILT SKETCH

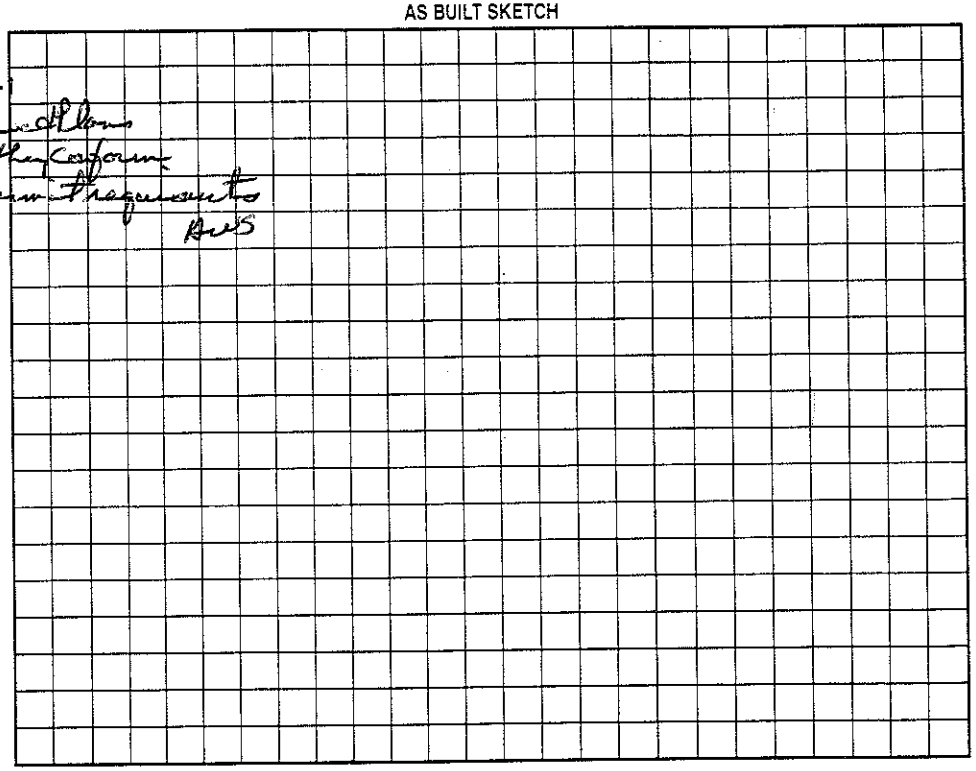

Permit can be suspended or revoked if any false information is supplied toward securing the permit/any unauthorized changes are made to the site/any unauthorized changes are made in the installation of the system. Improvement Permit with plat valid without expiration. Improvement Permit with site plan valid for sixty months. Authorization to Construct is valid for a period equal to that of Improvement Permit – not to exceed sixty months.

Signed: X Bill Campagna RS date 6/14/01 Installed by: Rowan Septic

Improvement Permit by: Mailon H. Gibson RS date 6/8/2001 Operation Permit by: [signature] RS date 9/6/01

Authorization to Construct by: Wesley Sparks RS date 6/14/01 Existing System Inspection by: date

HEALTH DEPT. COPY: WHITE OWNER COPY (FINAL): YELLOW OWNER COPY (INITIAL): PINK