IREDELL COUNTY HEALTH DEPARTMENT

STATESVILLE 704-878-5305 MOORESVILLE 704-664-5281

IMPROVEMENT PERMIT / AUTHORIZATION TO CONSTRUCT / OPERATION PERMIT / EXISTING SYSTEM INSPECTION

PERMIT# 112811 PIN# 4635575515 DATE 8-19-08

OWNER OR APPLICANT Albert S Wray - Jeffrey Davis PHONE: Business 704-458-5213 Home

ADDRESS 130 Enwood Dr. Charlotte NC 28214

LOCATION Brawley School Rd, TL Stutts, TR Shore line LP, corner of Shoreline & Imperial

SUBDIVISION BayView Estates BLOCK / SECTION LOT 24 LOT AREA .437 AC SITE CLASS. PS DESIGN FLOW 450' L.T.A.R. .3

Septic Tank: 1000 Gallons: STB 794 Date

Pump Tank: 1000 Gallons: PT 283 Date

Pump Make: Champion Model CPE5 Serial No. 1/2hp

Nitrification Field: No Fields 1 Square Feet 1200' Linear Feet 400'

No Lines 4 @ 100' Trench Width 36" Max Trench Bottom Depth 36" Gravel Depth —

☒ New System ☐ Repair ☐ Expansion System Type: I II III IV V VI

System Description: PM - 25% Red.

Repair System Description: LP - PPBPS

Maintenance Agreement Required: ☐ Yes ☒ No Initially

☒ House/Mod. Home ☐ Mobile Home ☐ Business ☐ Other

No. Bedrooms 4 No. Persons No. Employees


Water Supply: ☒ Individual ☐ Public ☐ Community

☐ Gravity ☒ Pressure ☐ Slab ☒ Crawl Space ☐ Basement w/plumbing ☐ Basement wo/plumbing


Comments/Conditions: 1) Drain lines & tanks must be 10' off prop. lines 2) Tanks must be 5' off house 3) Drain lines must be 5' off house

Comments/Conditions:

Pressure Manifold INITIAL SITE SKETCH

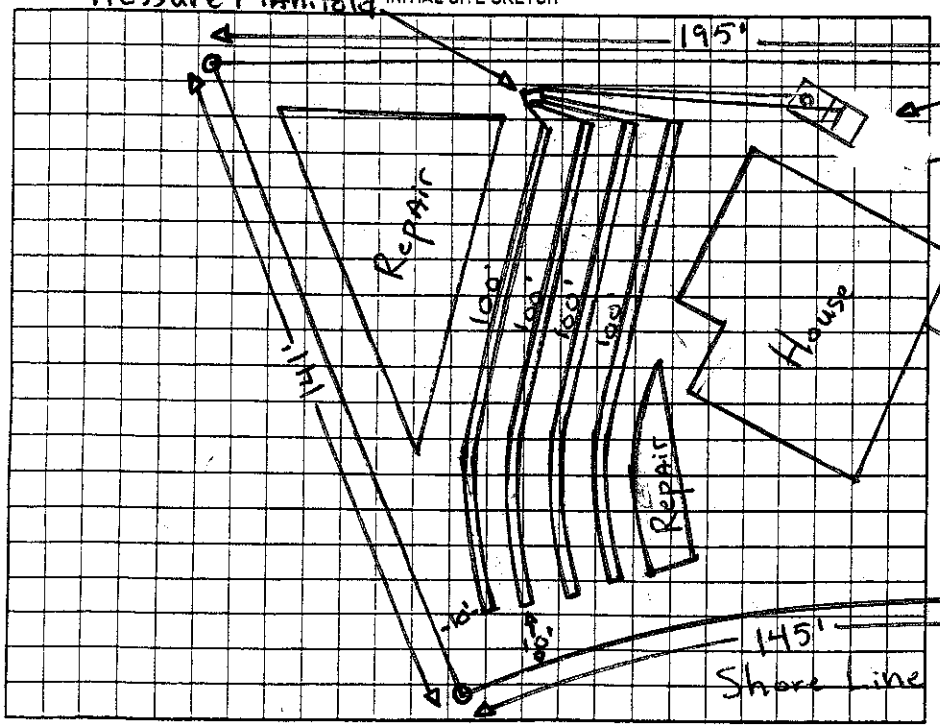

AS BUILT SKETCH

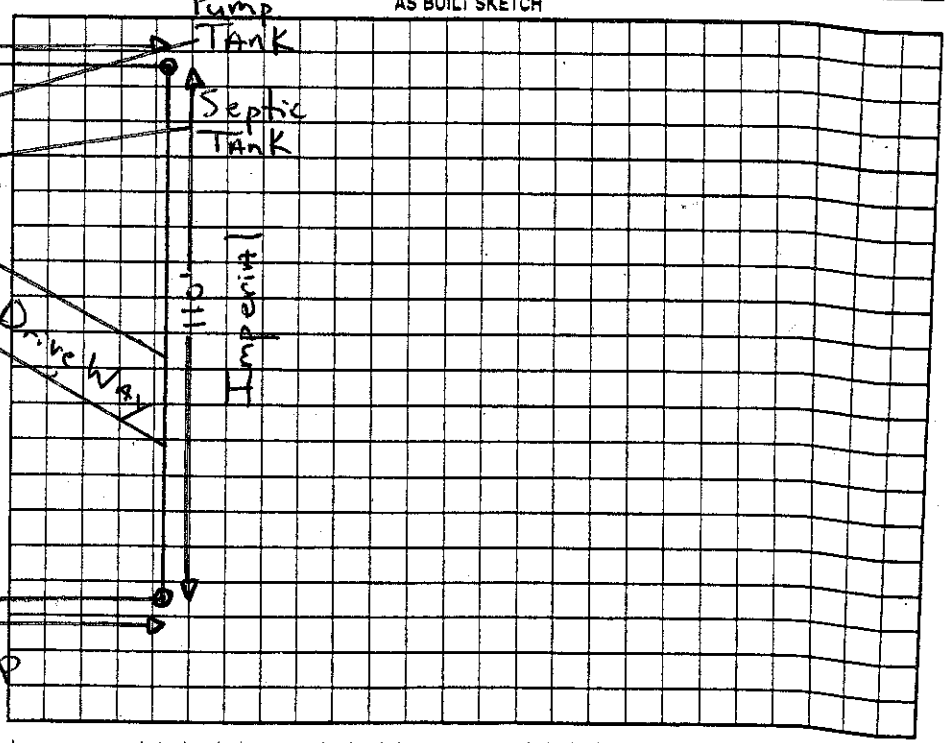

Permit can be suspended or revoked if any false information is supplied toward securing the permit/any unauthorized changes are made to the site/any unauthorized changes are made in the installation of the system. Improvement Permit with plat valid without expiration ☐ Improvement Permit with site plan valid for sixty months ☒ Authorization to Construct is valid for a period equal to that of Improvement Permit – not to exceed sixty months.

Signed: Albert Wray date 8/21/08 Installed by: Stutts

Improvement Permit by: date 8-19-08 Operation Permit by: date 9-2-08

Authorization to Construct by: date 8-19-08 Existing System Inspection by: date

HEALTH DEPT. COPY: WHITE OWNER COPY (FINAL): YELLOW OWNER COPY (INITIAL): PINK