IREDELL COUNTY HEALTH DEPARTMENT

STATESVILLE 704-878-5305 MOORESVILLE 704-664-5281

IMPROVEMENT PERMIT / AUTHORIZATION TO CONSTRUCT / OPERATION PERMIT / EXISTING SYSTEM INSPECTION

PERMIT# 079673 PIN# 4635 57 9131 4635-57-9131 DATE 8/2/99

OWNER OR CONTRACTOR Ray Short PHONE: Business 704/664/6761 Home

ADDRESS 470 Stutts Rd Mooresville NC 28117

LOCATION Br. Sch, TL Stutts, TR Shoreline

SUBDIVISION Imperial Pointe BLOCK / SECTION LOT 17 LOT AREA 1.0 SITE CLASS. PS DESIGN FLOW 360 L.T.A.R. .3

Septic Tank: 1000 Gallons; STB 825 Date 10/9/99
Pump Tank: Gallons; PT Date
Pump Make: Model Serial No.
Nitrification Field: No Fields 1 Square Feet 1200 Linear Feet 400
No. Lines 4@100 Trench Width 36" Max Trench Bottom Depth 36" Gravel Depth 12

☒ New System ☐ Repair System Type: (I) II, III, IV, V, VI
System Description: Grav./Conv.
Repair System Description: Not Required
Maintenance Agreement Required: ☐ Yes ☐ No


☒ House/Mod. Home No. Bedrooms 3
☐ Mobile Home No. Bathrooms 2
☐ Business No. Employees
☐ Other
☐ Slab ☒ Crawl Space ☐ Basement w/plumbing ☐ Basement wo/plumbing

Water Supply: ☒ Individual ☐ Public ☐ Community

Comments:/Conditions: Scale 1-60

Comments:/Conditions:

INITIAL SITE SKETCH

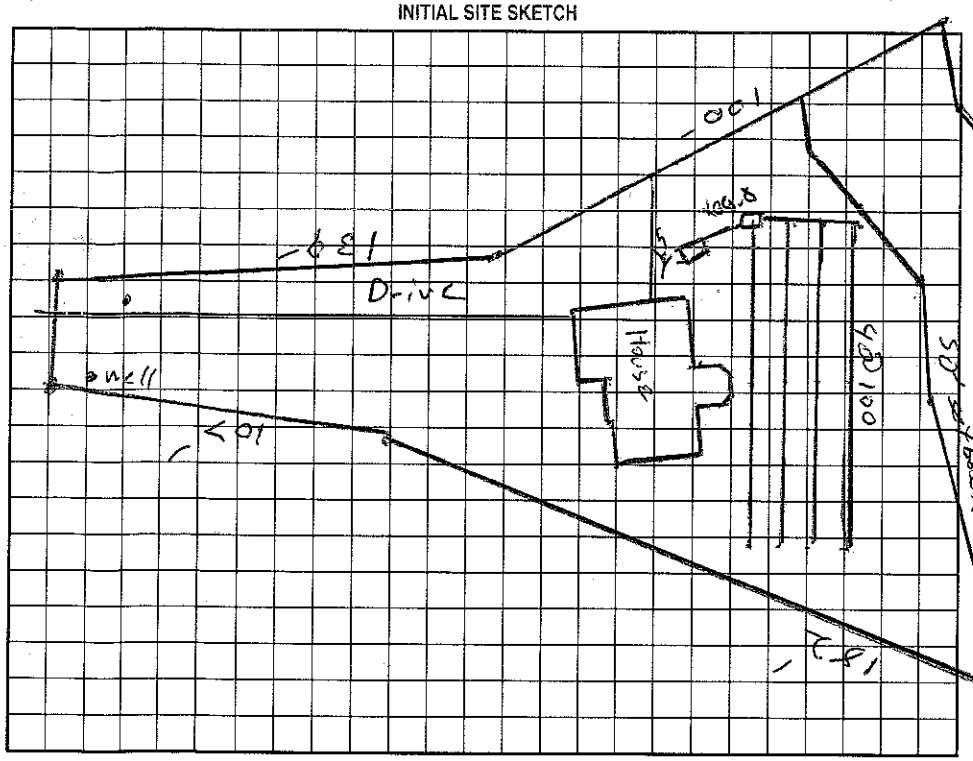

AS BUILT SKETCH

Permit can be suspended or revoked if any false information is supplied toward securing the permit/any unauthorized changes are made to the site/any unauthorized changes are made in the installation of the system. Improvement Permit with plat valid without expiration. Improvement Permit with site plan valid for sixty months. Authorization to Construct is valid for a period equal to that of Improvement Permit – not to exceed sixty months.

Signed: Ray Short date 8-6-99 Installed by: Wayne Clontz

Improvement Permit by: Jeff Morgan date 8/2/99 Operation Permit by: Wesley Sparks RS date 11/23/99

Authorization to Construct by: Jeff Morgan date 8/2/99 Existing System Inspection by: date

HEALTH DEPT. COPY: WHITE OWNER COPY (FINAL): YELLOW OWNER COPY (INITIAL): PINK