IREDELL COUNTY HEALTH DEPARTMENT

STATESVILLE 704-878-5305 MOORESVILLE 704-664-5281

IMPROVEMENT PERMIT / CERTIFICATE OF COMPLETION / OPERATION PERMIT / EXISTING SYSTEM INSPECTION

PROPERTY DESCRIPTION NO. _____ DATE Jan. 13, '94 TAX MAP NO. 4635-57-9200 Watershed: ☑ Yes ☐ No

OWNER OR CONTRACTOR Donna Ferrell PHONE: Business 339-0884 Home L.M.

ADDRESS _____

LOCATION 1100 Tf 1112 Bear Rt at Lake onto Shoreline Loop 13th house on left

SUBDIVISION Imperial Pt. BLOCK / SECTION _____ LOT 18 LOT AREA _____ SITE CLASS. _____ DESIGN FLOW _____ L.T.A.R. _____

Septic Tank: Existing Gallons; STB _____ Date _____

Pump Tank: _____ Gallons; PT _____ Date _____

Pump Make: _____ Model _____ Serial No. _____

Nitrification Field: No Fields 1+6 Square Feet 900 Linear Feet 300

No Lines 5 in bed Trench Width 15' Max Trench Bottom Depth No deeper than necessary Gravel Depth 12"

☐ New System ☑ Repair System Type: I II III IV, V, VI

System Description: gravity bed

Repair System Description: _____

Maintenance Agreement Required: ☐ Yes ☑ No

☑ House/Mod. Home No. Bedrooms 4/2

☐ Mobile Home No. Bathrooms

☐ Business No. Employees

☐ Other _____


☐ Slab ☑ Crawl Space ☐ Basement w/plumbing ☐ Basement wo/plumbing

Water Supply: ☑ Individual ☐ Community ☐ Public

Comments: Set Ball Rym Valve and divert flow to new drainfield. Relandscape and sow grass over repair field once completed.

Comments:

INITIAL SITE SKETCH

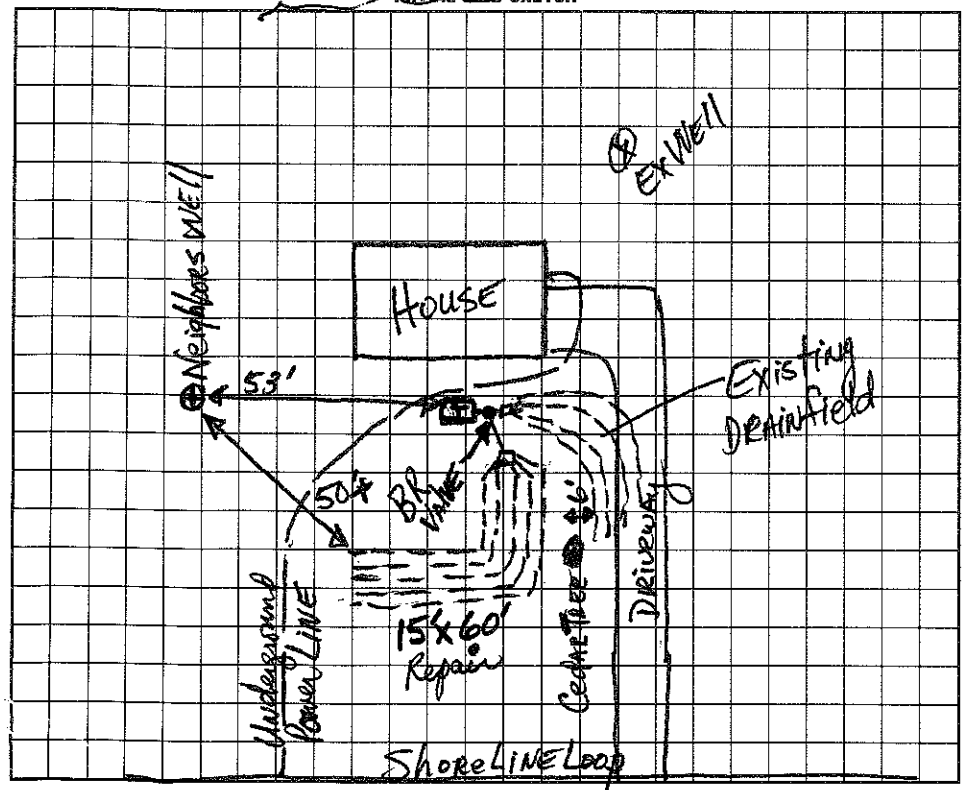

AS BUILT SKETCH

I understand that this permit can be suspended or revoked if any false information is supplied toward securing the permit/any unauthorized changes are made to the site/any unauthorized changes are made in the installation of the system. Improvement Permit is valid for 60 months from date of issuance.

Signed X Donna Ferrell

Improvement Permit by: Mark R. Hinson, RS date Jan 13, '94

Existing System Inspection by: _____ date _____

Installed by: Ken Christiana

Certificate of Completion by: _____ date _____

Operation Permit by: Wesley Sparks RS. date 1/22/94

HEALTH DEPT. COPY: WHITE INSPECTION COPY (FINAL): GREEN OWNER COPY (FINAL): YELLOW INSPECTION COPY (INITIAL): PINK OWNER COPY (INITIAL): GOLD