IREDELL COUNTY HEALTH DEPARTMENT

Statesville Office (704) 878-5305 | Mooresville Office (704) 660-3625 | PERMIT # 205561

IMPROVEMENT PERMIT / AUTHORIZATION TO CONSTRUCT / OPERATION PERMIT / EXISTING SYSTEM

PIN # 4635 58 1861

APPLICANT: Kromerica, LLC | APPLICANT ADDRESS: 1601 Ringneck Trail Mooresville, NC 28117

SITE ADDRESS: 142 Shoreline Loop Mooresville, NC | PHONE: | ALT. PHONE: 704 609-8668

SITE DIRECTIONS: Brawley School Rd TL Stotts Rd TR Shoreline Lp on right before lake


SUBDIVISION: Bay View Estates | SECTION: — | LOT # 8 | LOT AREA: ~~14,529~~ 1.45A | DESIGN FLOW: 480 gpd | L.T.A.R.: .3

Septic Tank	1000 (gal)	STB	794	Date	1-21-16	☒ New System ☐ Repair ☐ Expansion	System Type: I II (III) IV V VI	☒ Residence	No. Bedrooms	4	Water Supply
Pump Tank	1000 (gal)	PT	283	Date	4-11-16	System Description: Pump-PM- PPBPS		☐ Business	No. Persons	8	☒ Private
Pump Make	Champion	Model	CPE5A-12	Serial #	C17697	Repair System Description: Repair exempt 7-10-65		☐ Other	No. Employees		☐ Public
# Nitrification Fields	1	# Lines	6	Linear Ft:	270	Maintenance Agreement Required: ☐ YES ☒ NO		☐ Slab	☐ Crawl Space		☐ Community
Trench Width	min. 24"	Max. Trench Bottom Depth	36"	Gravel Depth	N/A	☐ GRAVITY ☒ PRESSURE		☒ Basement w/plumbing			☐ Basement w/o plumbing

Comments / Conditions: Must keep Septic at least 50ft from any well. Keep Supply line at least 50ft from any well if less than 50ft must be encased in Ductile iron. Supply line must be at least 25' towell.

Keep ST & PT 5ft from basement wall. Drainfield 25ft to basement wall. Keep Supply line 10ft from basement. ST/PT at least 5ft from PL.

INITIAL SITE SKETCH

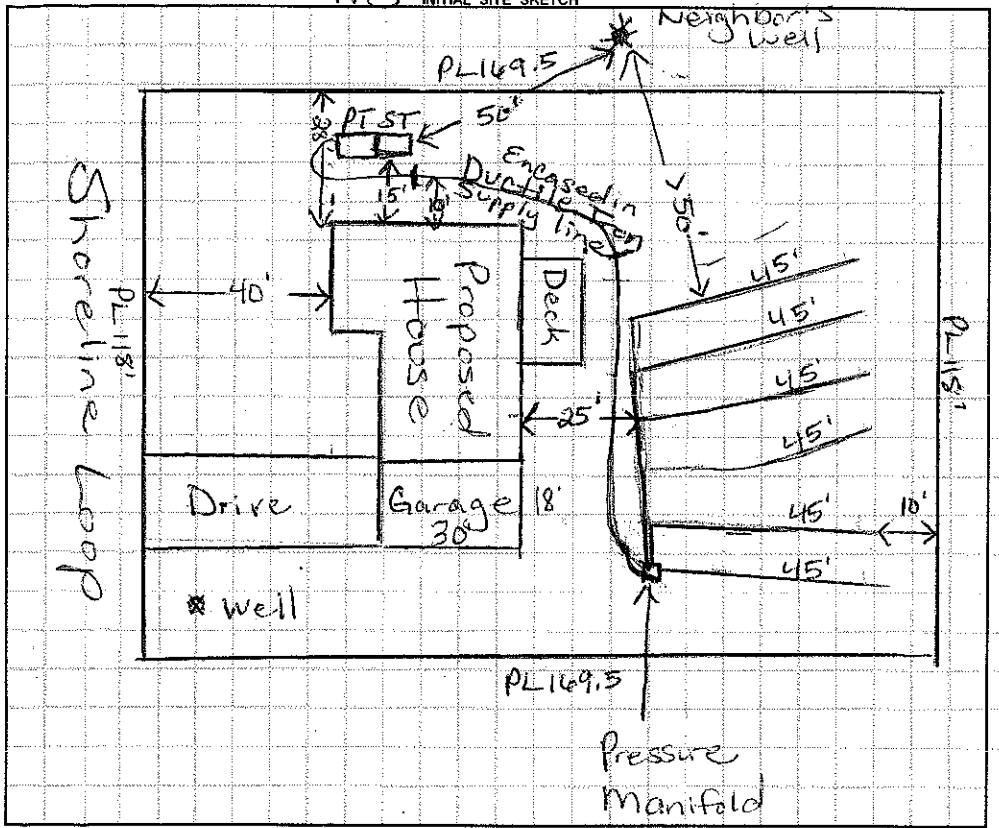

AS BUILT SKETCH

5/26/16 Checked tanks & upper 4 lines. MO

Scale 1:40

5-27-16 - Lowest 2 lines OK. Pump line + manifold OK

Permit can be suspended or revoked if any false information is supplied toward securing the permit / any unauthorized changes are made to the site / any unauthorized changes are made in the installation of the system. **CONTACT A LOCATOR SERVICE PRIOR TO ANY EXCAVATION**

☐ **IMPROVEMENT PERMIT** *with plat valid without expiration.* ☐ **IMPROVEMENT PERMIT** *with site plan valid for 60 mos.* ☒ **AUTHORIZATION TO CONSTRUCT** *valid for period equal to IMPROVEMENT PERMIT--not to exceed 60 mo.*

Owner / Applicant Signature: Jina B. Krohn | Date: 3/11/16 | Installed by: Bass Grading

IMPROVEMENT PERMIT by: Marian Dotson RS | Date: 3/4/16 | OPERATION PERMIT by: W Sparks | Date: 10/5/16

AUTHORIZATION TO CONSTRUCT by: Marian Dotson RS | Date: 3/4/16 | Existing System Inspected by: | Date:

Health Dept. Copy - WHITE Applicant (Final Approval) - YELLOW Applicant (Conditional Approval) - PINK