COUNTY HEALTH DEPARTMENT

STATESVILLE [illegible]-5305 MOORESVILLE 704-664-5281

/EMENT PERMIT / AUTHORIZATION TO CONSTRUCT / OPERATION PERMIT / EXISTING SYSTEM INSPECTION

N/A (Repair) PIN # 4635583439 DATE 10-28-09

APPLICANT Alana Fabiola Campos PHONE: Business Home: (704) 572-0939

or APPLICANT ADDRESS 283 Wood Duck Lp Mooresville, NC 28117

ION / DIRECTIONS Brawley School Rd TL Stutts Rd TR Shoreline Dr TL Bayview on Rt. #108

SUBDIVISION Bayview BLOCK / SECTION LOT # 38 LOT AREA DESIGN FLOW 360gpd L.T.A.R. .25-.3

Septic Tank 1000 Gallons: STB Date

Pump Tank Gallons: P T Date

Pump Make Model Serial #

Nitrification Field No Fields 1 No Lines 3 Linear Feet 290'-300

Trench Width 36" Max. Trench Bottom Depth 36" Gravel Depth N/A

☐ New System ☒ Repair ☐ Expansion System Type I (II) III IV V VI

System Description: Gravity--Conventional (Bed)

Repair System Description: Gravity - 25% Reduction

Maintenance Agreement Required ☐ YES ☒ NO

☐ GRAVITY ☐ PRESSURE

☒ Residence No. Bedrooms 3 ☐ Business No. Persons ☐ Other No. Employees ☐ Slab ☐ Crawl Space ☐ Basement w/plumbing ☐ Basement w/o plumbing


Water Supply: ☒ Private ☐ Public ☐ Community

Comments / Conditions: Install Bull run Valve to switch btw Drainfields. Keep Septic System at least 50ft from any well.

Scale 1:40

Comments / Conditions: Owner must have Property Corners marked prior to installing Drainfield. Keep Septic System at least 5ft from PL

INITIAL SITE SKETCH

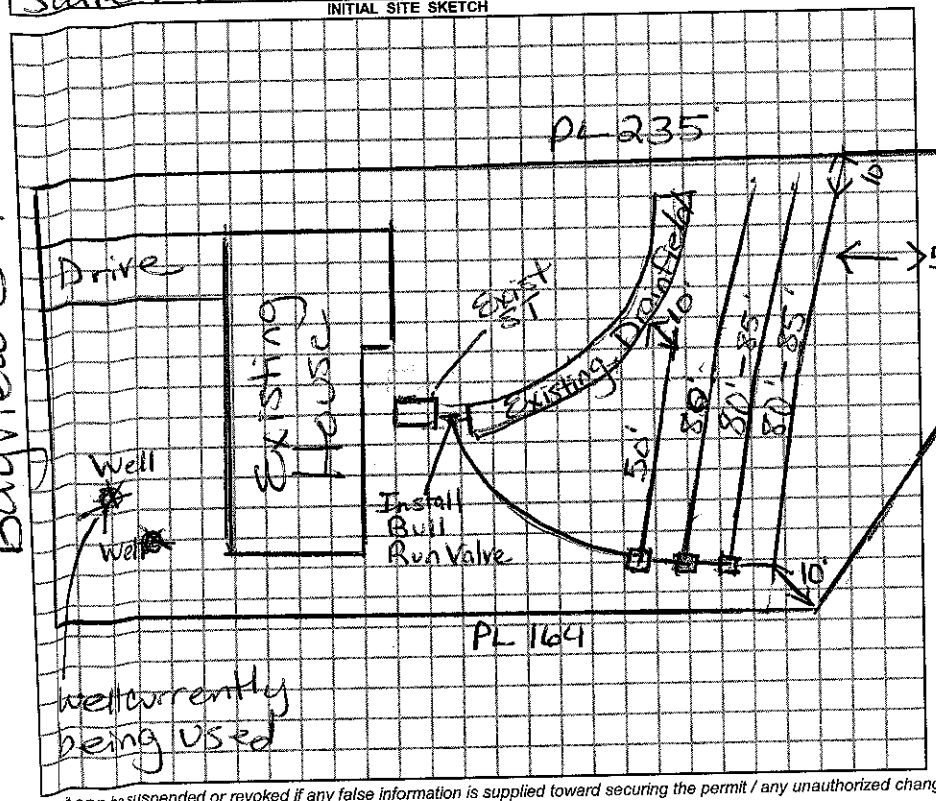

AS BUILT SKETCH

12/1/09 Checked New lines

Bayview Dr.

Permit can be suspended or revoked if any false information is supplied toward securing the permit / any unauthorized changes are made to the site / any unauthorized changes are made in the installation of the system.

☐ *IMPROVEMENT PERMIT w / plat valid without expiration.* ☐ *IMPROVEMENT PERMIT w / site plan valid for 60 mos.* ☐ *AUTHORIZATION TO CONSTRUCT valid for period equal to IMPROVEMENT PERMIT-not to exceed 60 mo.*

Owner / Applicant Signature: Fabiola Campos Date 10/30/09

Repair Improvement Permit by: Maria H. Dotson Date 10/28/09

Repair Authorization to Construct by: Maria H. Dotson Date 10/28/09

Installed by: Wayne Glotzbach RS Date: 12/1/09

Operation Permit by: Maria H. Dotson Date:

Existing System Inspected by: Date:

I SHOULD CONTACT A LOCATOR SERVICE PRIOR TO ANY EXCAVATION.

WHITE COPY Environmental Health YELLOW COPY (Final) Owner / Applicant PINK COPY (Initial) Owner / Applicant