3 30

IREDELL COUNTY HEALTH DEPARTMENT

STATESVILLE 704-878-5305 MOORESVILLE 704-664-5281

IMPROVEMENT PERMIT / AUTHORIZATION TO CONSTRUCT / OPERATION PERMIT / EXISTING SYSTEM INSPECTION

PERMIT# 082370 PIN# 4635583640

OWNER OR CONTRACTOR Allen Campi Real Estate Agent (Janet Faulk) DATE 7/8/99

ADDRESS 283 Wood Duck Loop Mooresville NC PHONE: Business 528-6636 Home 664-2690

LOCATION Brawley School TL Stutts TR Shoreline at Corner of Bayview

SUBDIVISION Bayview Estates BLOCK / SECTION ____ LOT 37 LOT AREA ____ SITE CLASS. ____ DESIGN FLOW 480 gpd L.T.A.R. 1.3

Septic Tank: 1000 Gallons; STB 794 Date 4-22-01

Pump Tank: ____ Gallons; PT ____ Date ____

Pump Make: ____ Model ____ Serial No. ____

Nitrification Field: No Fields 1 Square Feet 1200' Linear Feet 400'

No Lines 4 at 100' Trench Width 36" Max Trench Bottom Depth 36" Gravel Depth N/A

[X] New System [ ] Repair System Type: I, II, (III) IV, V, VI

System Description: Gravity - 25% Reduction

Repair System Description: ~~Same~~ Panel

Maintenance Agreement Required: [ ] Yes [X] No

[X] House/Mod. Home [ ] Mobile Home [ ] Business [ ] Other

No. Bedrooms 4 No. Bathrooms 2.5 No. Employees ____


Water Supply: [X] Individual [ ] Public [ ] Community

[X] Slab [X] Crawl Space [ ] Basement w/plumbing [ ] Basement wo/plumbing

Comments:/Conditions: Keep Septic System at least 10' from PL, 5' from House & 50' from any well.

Comments:/Conditions: Grey filter installed Speed levelers installed

INITIAL SITE SKETCH Scale 1:50'

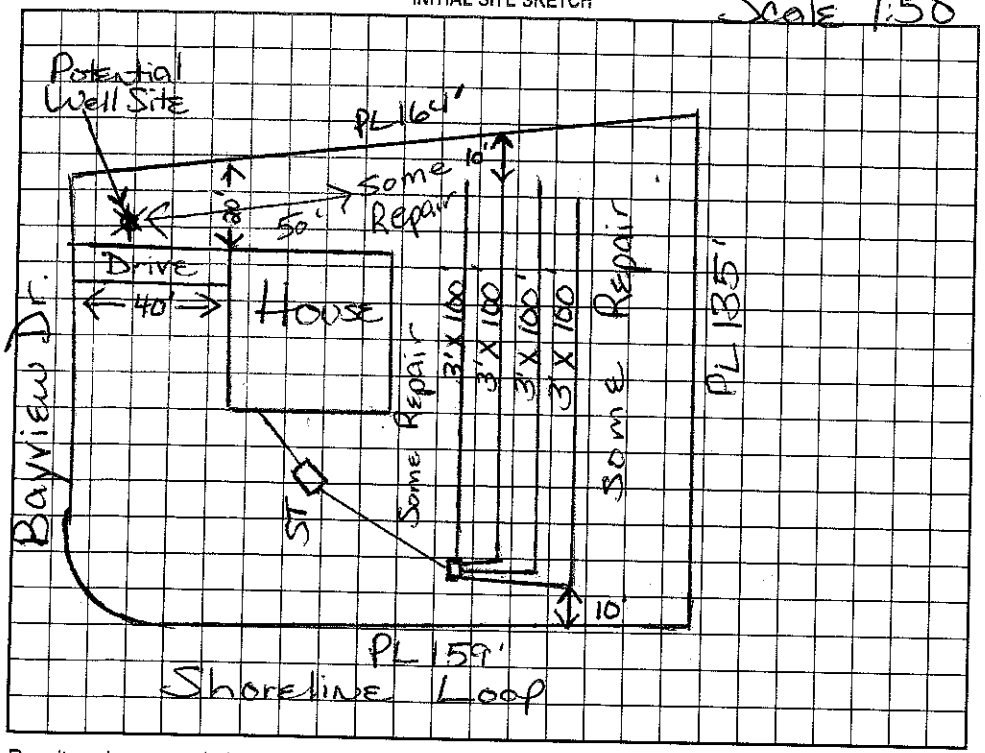

AS BUILT SKETCH

Installed EZ Flow Drainlines (as drawn)

Permit can be suspended or revoked if any false information is supplied toward securing the permit/any unauthorized changes are made to the site/any unauthorized changes are made in the installation of the system. Improvement Permit with plat valid without expiration. Improvement Permit with site plan valid for sixty months. Authorization to Construct is valid for a period equal to that of Improvement Permit – not to exceed sixty months.

Signed: Miranda L. Underwood date 1-12-99

Improvement Permit by: Maria H.H. Dotson RS date 7/9/99

Authorization to Construct by: Maria H.H. Dotson RS date 7/9/99

Installed by: Upright Grading

Operation Permit by: Maria H.H. Dotson RS date 7/31/2001

Existing System Inspection by: ____ date ____

HEALTH DEPT. COPY: WHITE OWNER COPY (FINAL): YELLOW OWNER COPY (INITIAL): PINK