IREDELL COUNTY HEALTH DEPARTMENT

STATESVILLE 704-878-5305 130.00 Paid MOORESVILLE 704-664-5281

IMPROVEMENT PERMIT / AUTHORIZATION TO CONSTRUCT / OPERATION PERMIT / EXISTING SYSTEM INSPECTION

PERMIT# 114448 PIN# 4635-58-3891

OWNER OR CONTRACTOR Campagna Homes, Inc. DATE 8/5/03

ADDRESS 308 Blume Rd Mooresville NC 28117 PHONE: Business 704-654-1185 Home

LOCATION BSR, TL Stutts, TR Shoreline Dr, 4th on Rt.

SUBDIVISION Bayview Est. BLOCK / SECTION LOT 6 LOT AREA 20,000 Ft2 SITE CLASS. PS DESIGN FLOW 480 L.T.A.R. 0.3

Septic Tank: 1000 Gallons; STB 525 Date 11/15/04

Pump Tank: Gallons; PT Date

Pump Make: Model Serial No.

Nitrification Field: No Fields 1 Square Feet 810 Linear Feet 270'

No Lines 5@54' Trench Width 24" or 36" Max Trench Bottom Depth 36" Gravel Depth —

☒ New System ☐ Repair System Type: I, II, (III), IV, V, VI

System Description: Gravity Panel Block

Repair System Description: Pump Panel Block

Maintenance Agreement Required: ☐ Yes ☒ No

☒ House/Mod. Home ☐ Mobile Home ☐ Business ☐ Other

No. Bedrooms 4 No. Bathrooms 2½ No. Employees


☐ Slab ☒ Crawl Space ☐ Basement w/plumbing ☐ Basement wo/plumbing

Water Supply: ☒ Individual ☐ Public ☐ Community

Comments:/Conditions: 8 Proc. 9 Proc

1"=40"

INITIAL SITE SKETCH

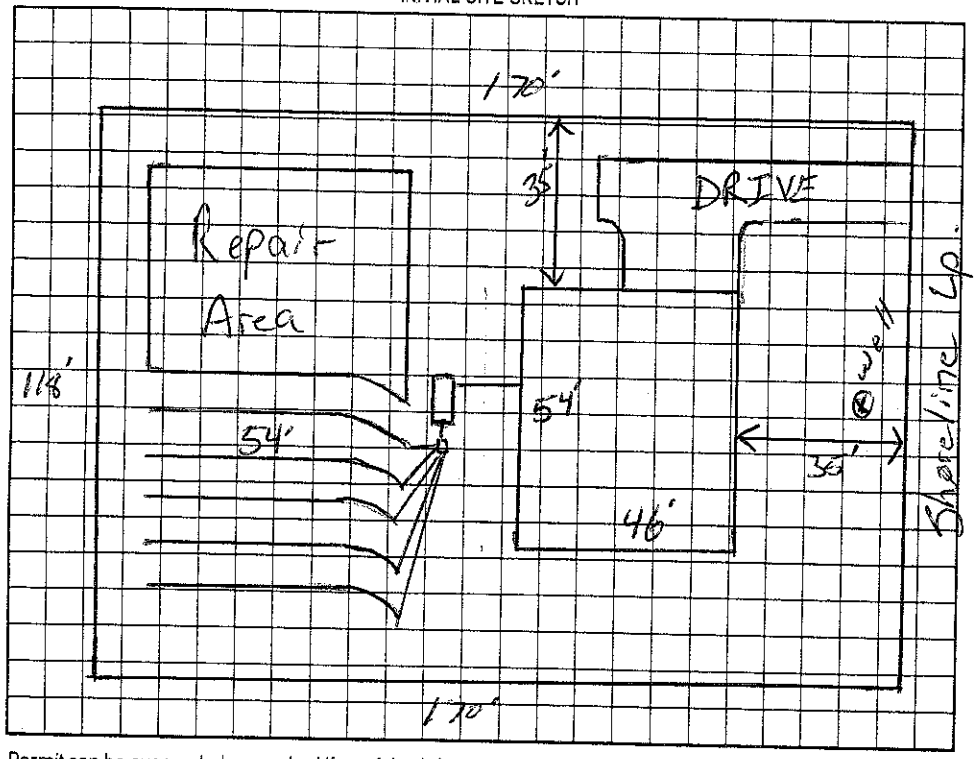

Comments:/Conditions:

AS BUILT SKETCH

Installed As Drawn

Permit can be suspended or revoked if any false information is supplied toward securing the permit/any unauthorized changes are made to the site/any unauthorized changes are made in the installation of the system. Improvement Permit with plat valid without expiration. Improvement Permit with site plan valid for sixty months. Authorization to Construct is valid for a period equal to that of Improvement Permit – not to exceed sixty months.

Signed: Neil Campagna date 8/15/03

Improvement Permit by: RS date 8/5/03

Authorization to Construct by: RS date 9/21/04

Installed by: Rowan Septic

Operation Permit by: RS date 2/2/05

Existing System Inspection by: date

HEALTH DEPT. COPY: WHITE OWNER COPY (FINAL): YELLOW OWNER COPY (INITIAL): PINK