IREDELL COUNTY HEALTH DEPARTMENT

STATESVILLE 704-878-5305 MOORESVILLE 704-664-5281

IMPROVEMENT PERMIT / AUTHORIZATION TO CONSTRUCT / OPERATION PERMIT / EXISTING SYSTEM INSPECTION

PERMIT# 073557 PIN# 4635 58 2230 DATE 6/10/98

OWNER OR CONTRACTOR Michael Shelor PHONE: Business Home 892-7373

ADDRESS 170 Regal Circle Mooresville, NC. 28115

LOCATION 1100 TL St. Hs Rd TR Shoreline Loop ~ on (L)

SUBDIVISION Bayview Estates BLOCK / SECTION LOT 30 LOT AREA .4Ac SITE CLASS. PS DESIGN FLOW 480 L.T.A.R. .3

Septic Tank: 1000 Gallons; STB Date

Pump Tank: Gallons; PT Date

Pump Make: Model Serial No.

Nitrification Field: No Fields 1 Square Feet 1200* Linear Feet 400*

No Lines 5 Trench Width 36" Max Trench Bottom Depth 36" Gravel Depth SAND

☑ New System ☐ Repair System Type: I, II, (III) IV, V, VI

System Description: GRAV - CH PLASTIC

Repair System Description: 16" PPBS

Maintenance Agreement Required: ☐ Yes ☒ No

☒ House/Mod. Home ☐ Mobile Home ☐ Business ☐ Other

No. Bedrooms 4 No. Bathrooms 2.5 No. Employees


☐ Slab ☒ Crawl Space ☐ Basement w/plumbing ☐ Basement wo/plumbing

Water Supply: ☒ Individual ☐ Public ☐ Community

Comments:/Conditions: * 25% Reduction for Type III System
9/1/98 - 3 88' x 3' T+T Panel lines with Repair in same area - AWS.

Comments:/Conditions:
1/c 88x3' 16" PPBS - 269

INITIAL SITE SKETCH

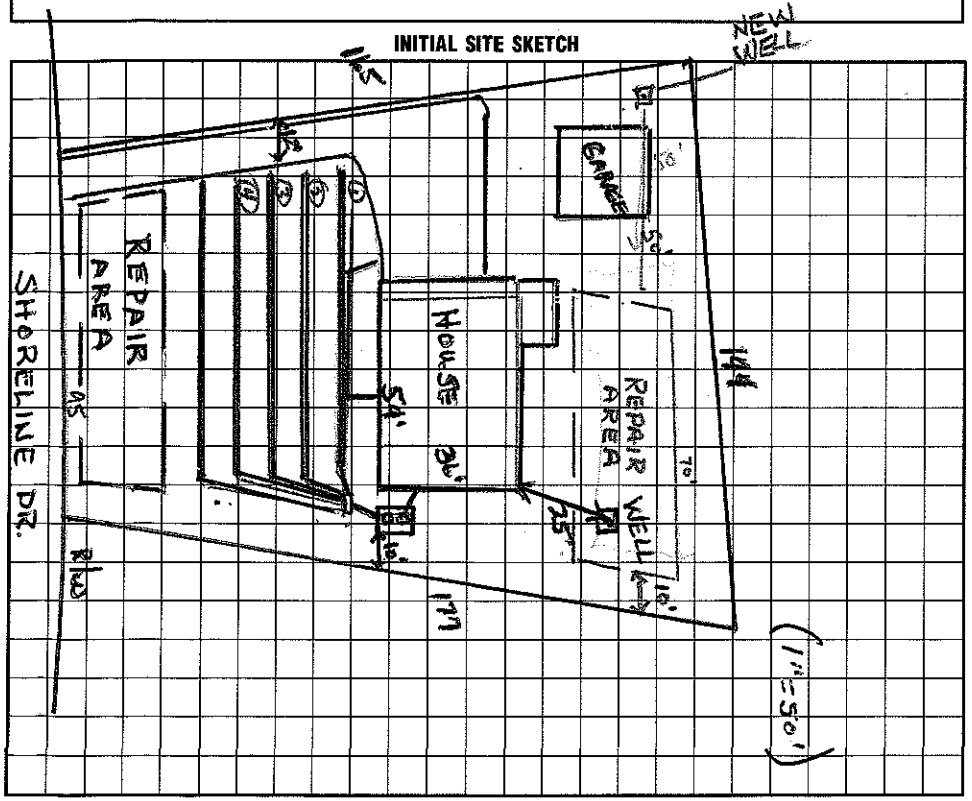

AS BUILT SKETCH

I understand that this permit can be suspended or revoked if any false information is supplied toward securing the permit/any unauthorized changes are made to the site/any unauthorized changes are made in the installation of the system. Improvement Permit with plat valid without expiration. Improvement Permit with site plan valid for sixty months. Authorization to Construct is valid for a period equal to that of Improvement Permit – not to exceed sixty months.

Signed: * Marie L Elliott date 6-15-98 Installed by:

Improvement Permit by: Wesley Sparks R.S. date 6/10/98 Operation Permit by: date

Authorization to Construct by: Wesley Sparks R.S. date 6/10/98 Existing System Inspection by: date

HEALTH DEPT. COPY: WHITE INSPECTION COPY (FINAL): GREEN OWNER COPY (FINAL): YELLOW INSPECTION COPY (INITIAL): PINK OWNER COPY (INITIAL): GOLD