IREDELL COUNTY HEALTH DEPARTMENT

STATESVILLE 704-878-5305 MOORESVILLE 704-664-5281

#130

IMPROVEMENT PERMIT / AUTHORIZATION TO CONSTRUCT / OPERATION PERMIT / EXISTING SYSTEM INSPECTION

PERMIT# 111832 PIN# 4635 58 5476 DATE 4/22/03

OWNER OR CONTRACTOR WILLIAM McCARTHY PHONE: Business Home 704-795-0901

ADDRESS 117 BAYVIEW DR MOORESVILLE, NC. 28117

LOCATION 1100 TL STUTTS RD TO END TR ON LAKESHORE, TR 2ND STREET (BAYVIEW) TO 3RD LOT ON (R)

SUBDIVISION BAY VIEW BLOCK / SECTION LOT 49 LOT AREA .45 SITE CLASS. P5 DESIGN FLOW 480 L.T.A.R. .25

Septic Tank: 1000 Gallons; STB Date 11/19/05

Pump Tank: Gallons; PT Date

Pump Make: Model Serial No.

Nitrification Field: No Fields 1 Square Feet 960 Linear Feet 320

No Lines 30/06 Trench Width 3' Max Trench Bottom Depth 3' Gravel Depth N/A

☒ New System ☐ Repair System Type: I, II, III, IV, V, VI

System Description: GRAVITY – 16" PPBAS

Repair System Description: & 1983 PLAT DATE

Maintenance Agreement Required: ☐ Yes ☒ No

☒ House/Mod. Home No. Bedrooms 4

☐ Mobile Home No. Bathrooms 2.5

☐ Business No. Employees

☐ Other


☐ Slab ☒ Crawl Space ☐ Basement w/plumbing ☐ Basement wo/plumbing

Water Supply: ☒ Individual ☐ Public ☐ Community

Comments:/Conditions:

1) Need to Review Home Plans before AC will be issued

INITIAL SITE SKETCH 139.9

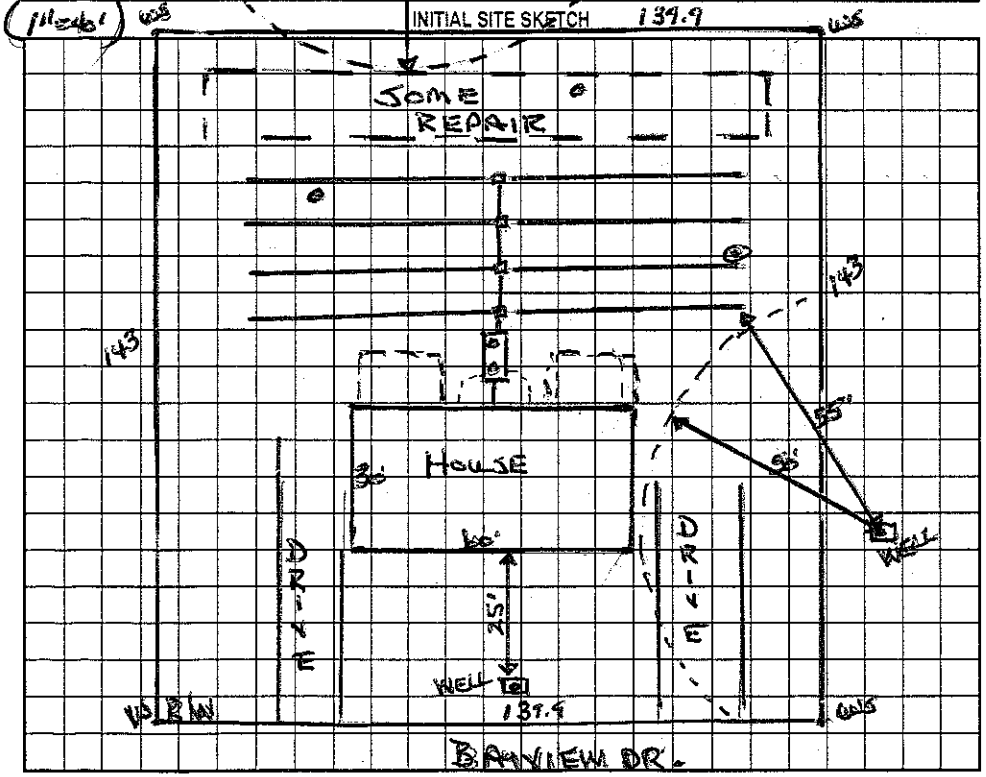

Comments:/Conditions:

AS BUILT SKETCH

Permit can be suspended or revoked if any false information is supplied toward securing the permit/any unauthorized changes are made to the site/any unauthorized changes are made in the installation of the system. Improvement Permit with plat valid without expiration. Improvement Permit with site plan valid for sixty months. Authorization to Construct is valid for a period equal to that of Improvement Permit – not to exceed sixty months.

Signed: William M. McCarthy date

Improvement Permit by: Wesley Sparks R.S. date 4/22/03

Authorization to Construct by: Wesley Sparks R.S. date 4/28/03

Installed by: Rowan Septic Tank

Operation Permit by: Wesley Sparks R.S. date 5/24/05

Existing System Inspection by: date

HEALTH DEPT. COPY: WHITE OWNER COPY (FINAL): YELLOW OWNER COPY (INITIAL): PINK