IREDELL COUNTY HEALTH DEPARTMENT

STATESVILLE 704-878-5305 MOORESVILLE 704-664-5281

IMPROVEMENT PERMIT / AUTHORIZATION TO CONSTRUCT / OPERATION PERMIT / EXISTING SYSTEM INSPECTION

PERMIT# Repair PIN# 4635-58-5811 DATE 10/15/04

OWNER OR CONTRACTOR Hubert Morton PHONE: Business _____ Home 704-664-5424

ADDRESS 124 Shoreline Lp Mooresville NC 28117

LOCATION BSR, TL Stutts, TR Shoreline Lp, 5th on Rt 124 Shoreline Lp

SUBDIVISION Bayview Est. BLOCK / SECTION _____ LOT 5 LOT AREA _____ SITE CLASS PS DESIGN FLOW 360 L.T.A.R. —

Septic Tank: Existing Gallons; STB _____ Date _____

Pump Tank: _____ Gallons; PT _____ Date _____

Pump Make: _____ Model _____ Serial No. _____

Nitrification Field: No Fields ____ Square Feet 600 Linear Feet 200

No Lines 4@50' Trench Width 36" Max Trench Bottom Depth 36" Gravel Depth 18"

☐ New System ☒ Repair System Type: I, (II), III, IV, V, VI

System Description: _____

Repair System Description: Gravity Conventional

Maintenance Agreement Required: ☐ Yes ☒ No

☒ House/Mod. Home No. Bedrooms 3

☐ Mobile Home No. Bathrooms ____

☐ Business No. Employees ____

☐ Other _____


☐ Slab ☒ Crawl Space ☐ Basement w/plumbing ☐ Basement wo/plumbing

Water Supply: ☒ Individual ☐ Public ☐ Community Existing


Comments:/Conditions: Disconnect old system

Comments:/Conditions:

INITIAL SITE SKETCH NOT to Scale

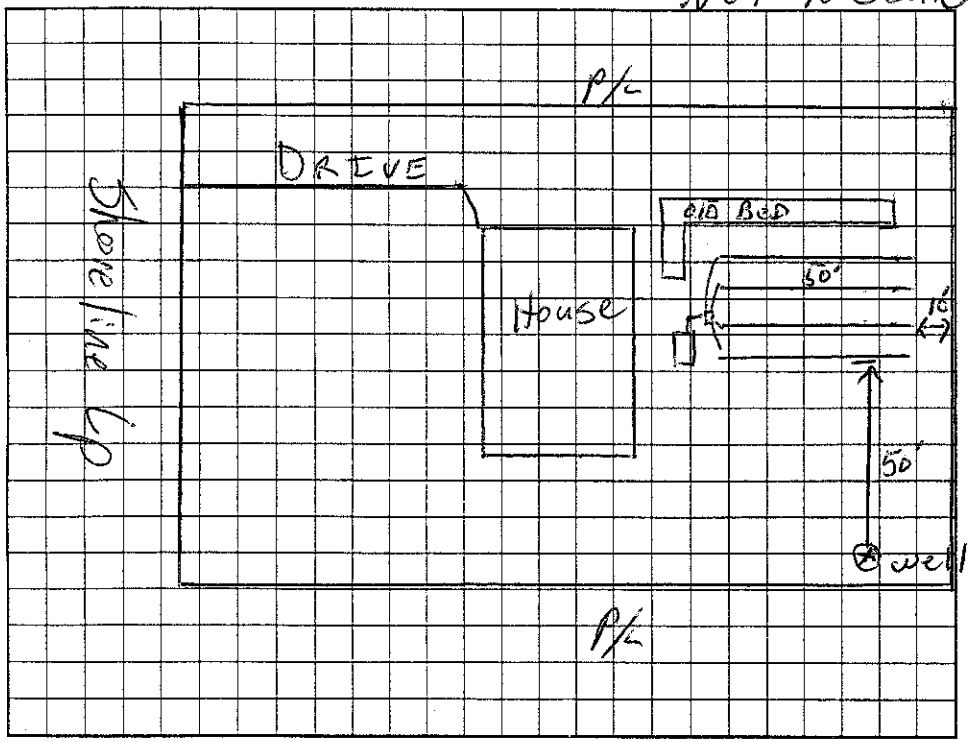

AS BUILT SKETCH

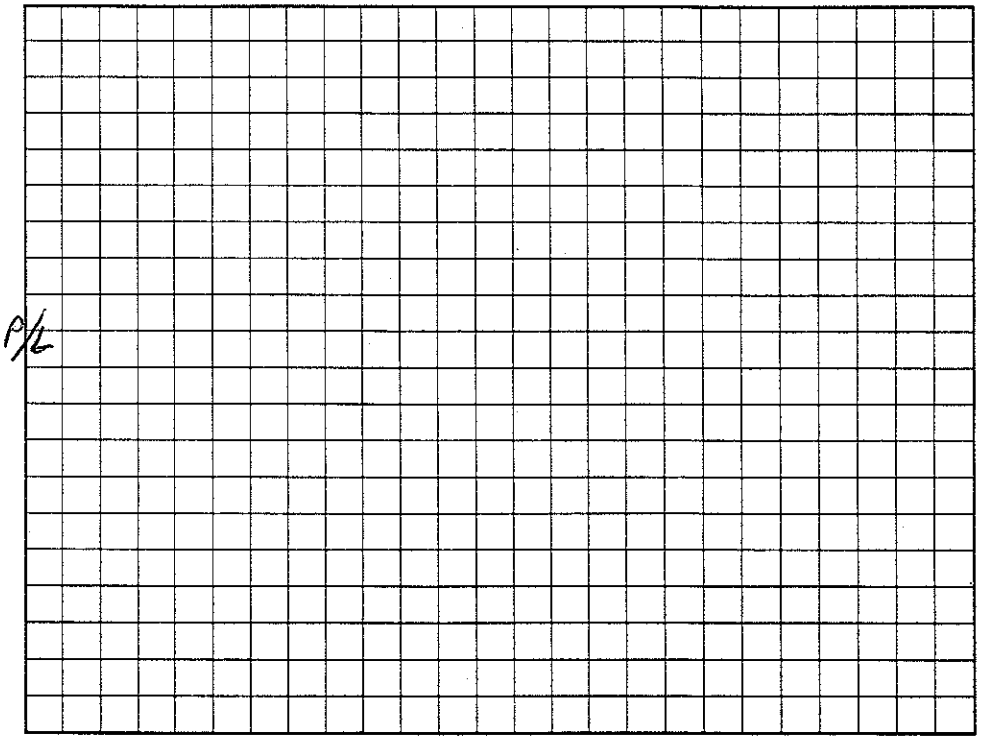

Permit can be suspended or revoked if any false information is supplied toward securing the permit/any unauthorized changes are made to the site/any unauthorized changes are made in the installation of the system. Improvement Permit with plat valid without expiration. Improvement Permit with site plan valid for sixty months. Authorization to Construct is valid for a period equal to that of Improvement Permit – not to exceed sixty months.

Signed: Hubert L Morton date _____ Installed by: Wayne Clontz

Improvement Permit by: RS date 10/15/04 Operation Permit by: RS date 12/3/04

Authorization to Construct by: RS date 10/15/04 Existing System Inspection by: _____ date _____

HEALTH DEPT. COPY: WHITE OWNER COPY (FINAL): YELLOW OWNER COPY (INITIAL): PINK