IREDELL COUNTY [illegible] DEPARTMENT

STATESVILLE 704-878-5305 MOORESVILLE 704-664-528[illegible]

IMPROVEMENT PERMIT / CERTIFICATE OF COMPLETION / OPERATION PERMIT / EXISTING SYSTEM INS[illegible]CTION

PROPERTY DESCRIPTION NO. 068558

OWNER OR CONTRACTOR JOHN FALLON DATE 10/13/97

ADDRESS 120 SHORELINE LP MOORESVILLE NC 28115 TAX MAP NO. 4635 55 8952

LOCATION BRAWLEY SCHOOL - TL STUTTS - 2nd ON RT PAST SOUTH END PHONE: Business 663-1666 Home Watershed: [illegible] No

SUBDIVISION BAYVIEW EST BLOCK / SECTION LOT 1 LOT AREA SITE CLASS. PS

Septic Tank: 1000 Gallons; STB 1012 Date 11/10/97

Pump Tank: Gallons; PT Date

Pump Make: Model Serial No.

Nitrification Field: No Fields 1 Square Feet 900 Linear Feet 300

No Lines 3 @ 100' Trench Width 36" Max Trench Bottom Depth 36" Gravel Depth N/A

☑ New System ☐ Repair System Type: I, II, ☑ III, IV, V, VI

System Description: GRAVITY CHAMBERED ORNO PANEL

Repair System Description:

Maintenance Agreement Required: ☐ Yes ☑ No

☑ House/Mod. Home ☐ Mobile Home ☐ Business ☐ Other

No. Bedrooms 3 No. Bathrooms 2 No. Employees


☐ Slab ☑ Crawl Space ☐ Basement w/plumbing ☐ Basement wo/plumbing

Water Supply: ☑ Individual ☐ Community ☐ Public

Comments:

Comments:

INITIAL SITE SKETCH

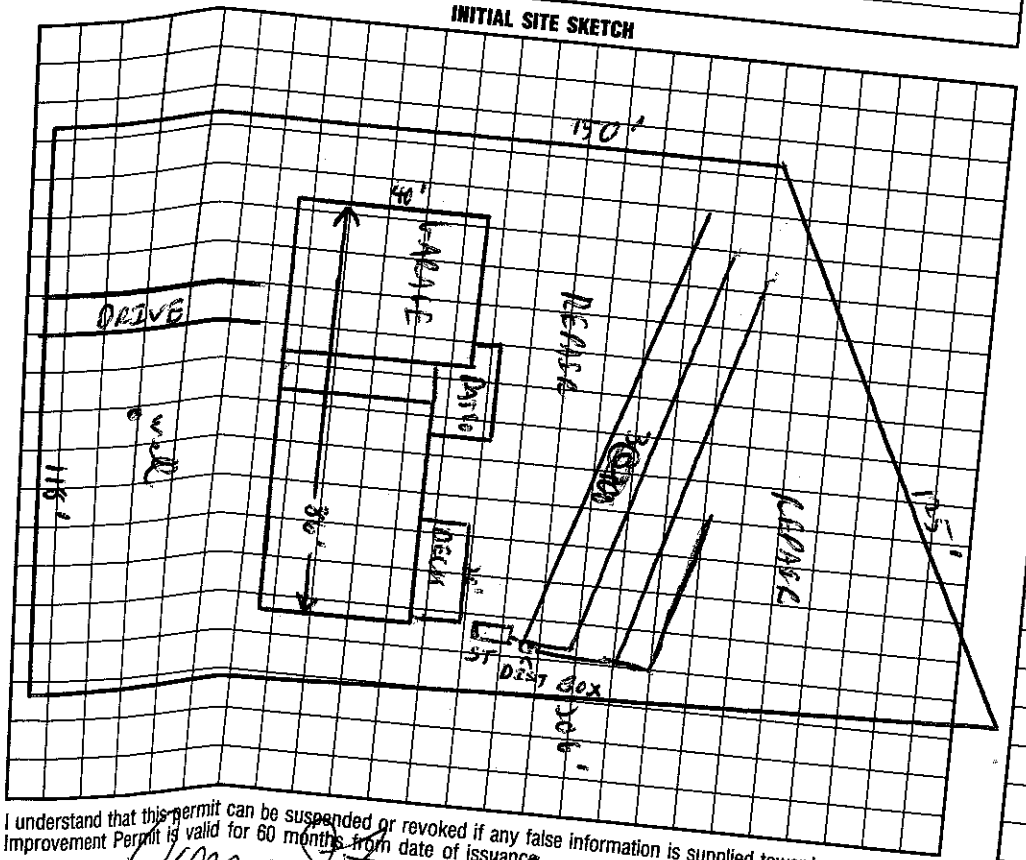

AS BUILT SKETCH

I understand that this permit can be suspended or revoked if any false information is supplied toward securing the permit/any unauthorized changes are made to the site/any unauthorized changes are made in the installation of the sy[illegible]
Improvement Permit is valid for 60 months from date of issuance.

Signed: John Fallon

Improvement Permit by: C. Ray Lee date 10/13/97

~~Existing System Inspection by:~~ AUTHORIZATION CONSENT C. Ray Lee date 10/13/97

HEALTH DEPT. COPY: WHITE INSPECTION COPY (FINAL): GREEN OWNER COPY (FINAL): YELLOW

Installed by: ATLANTIC GRADING

Certificate of Completion by:

Operation Permit by: C. Ray Lee

INSPECTION COPY (I[illegible]