Paid 125.00 04 10:30-11:00

IREDELL COUNTY HEALTH DEPARTMENT

STATESVILLE 704-878-5305 MOORESVILLE 704-664-5281

IMPROVEMENT PERMIT / AUTHORIZATION TO CONSTRUCT / OPERATION PERMIT / EXISTING SYSTEM INSPECTION

PERMIT# 089879 PIN# 4635589610 DATE 6/26/2000

OWNER OR CONTRACTOR Donald Isaman PHONE: Business Home 664-7139

ADDRESS 221 Commodore Lp. Mooresville, NC 28117

LOCATION Brawley School Rd TL Stutts TR Shoreline at corner OF Tamer LN.

SUBDIVISION Imperial Pt. BLOCK / SECTION LOT 43 LOT AREA .5 Acre SITE CLASS. PS DESIGN FLOW 360gpd L.T.A.R. .3

Septic Tank: 1000 Gallons; STB 1012 Date 10-15-2000

Pump Tank: Gallons; PT Date

Pump Make: Model Serial No.

Nitrification Field: No Fields 1 Square Feet 600' Linear Feet 200'

No Lines 5 at 40' Trench Width 36" Max Trench Bottom Depth 30"

☒ New System ☐ Repair System Type: I, II, III, IV, V, VI

System Description: Gravity- Panel Blk

Repair System Description: Panel Blk

Maintenance Agreement Required: ☐ Yes ☒ No

Gravel Depth N/A

☒ House/Mod. Home No. Bedrooms 3

☐ Mobile Home No. Bathrooms 2.5

☐ Business No. Employees

☐ Other

☐ Slab ☒ Crawl Space ☐ Basement w/plumbing ☐ Basement wo/plumbing


Water Supply: ☒ Individual ☐ Public ☐ Community

Comments:/Conditions: Keep Septic System at least 10' from PL, 50' From any well & 5' From house.

Comments:/Conditions: Polylok, filter installed

~1:40

INITIAL SITE SKETCH

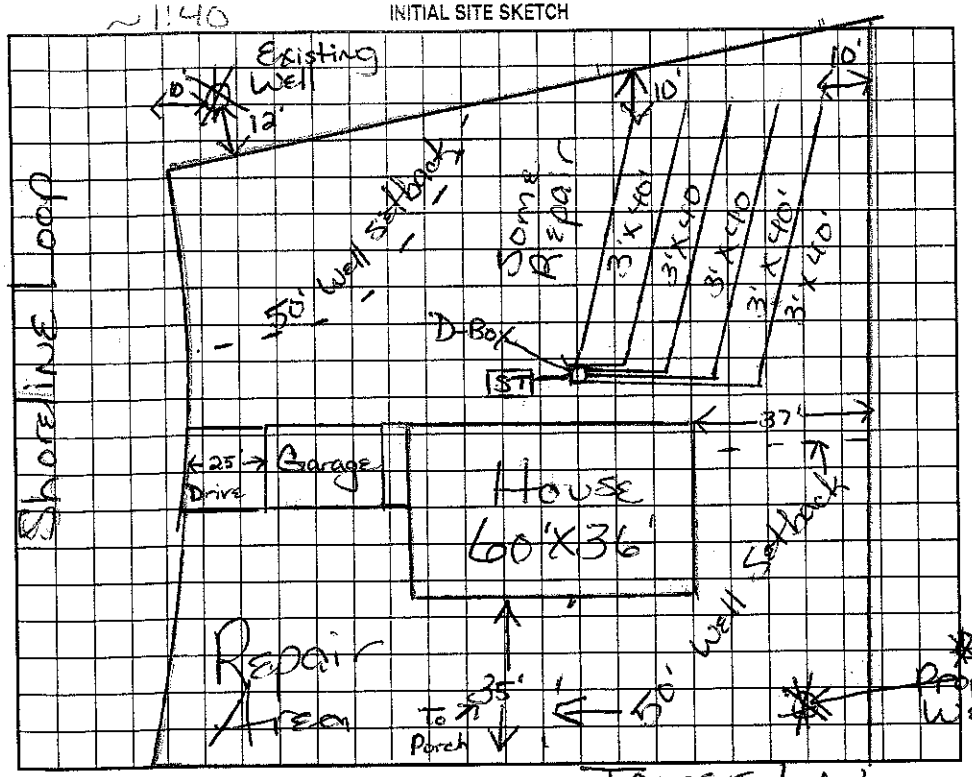

AS BUILT SKETCH

Installed as Drawn.
Installed Panel lines.

Permit can be suspended or revoked if any false information is supplied toward securing the permit, any unauthorized changes are made to the site/any unauthorized changes are made in the installation of the system. Improvement Permit with plat valid without expiration. Improvement Permit with site plan valid for sixty months. Authorization to Construct is valid for a period equal to that of Improvement Permit – not to exceed sixty months.

Signed: Donald Isaman date 8-23-00 Installed by: Richard Abernathy

Improvement Permit by: Maint H H Dotson BS date 6/26/00 Operation Permit by: Maint H H Dotson BS date 3/12/2001

Authorization to Construct by: Maint H H Dotson date 6/26/00 Existing System Inspection by: date

HEALTH DEPT. COPY: WHITE OWNER COPY (FINAL): YELLOW OWNER COPY (INITIAL): PINK