IREDELL COUNTY HEALTH DEPARTMENT

Statesville Office (704) 878-5305 Mooresville Office (704) 660-3625 DSE

PERMIT # 208424

IMPROVEMENT PERMIT / AUTHORIZATION TO CONSTRUCT / OPERATION PERMIT / EXISTING SYSTEM

PIN # 4655-59-0051

APPLICANT: BILLY ROBINSON APPLICANT ADDRESS: 178 SOUTHWOOD PARK RD.

SITE ADDRESS: SAME PHONE: 704-578-4951 ALT. PHONE:

SITE DIRECTIONS: STUTTS, TR SOUTHWOOD PARK, ON L

SUBDIVISION: MARINA VILLAGE SECTION: LOT # 27 LOT AREA: .9AC DESIGN FLOW: 360 L.T.A.R.: .3

Septic Tank 1000 (gal) STB 794 Date 9-21-15

Pump Tank (gal) PT Date

Pump Make Model Serial #

Nitrification Fields 1 # Lines 5 Linear Ft: 300'

Trench Width 36" Max. Trench Bottom Depth ~~20"~~ Gravel Depth —

☒ New System ☐ Repair ☐ Expansion System Type: I II (III) IV V VI

System Description: 25% REDUCTION

Repair System Description: PANEL BLOCK

Maintenance Agreement Required: ☐ YES ☒ NO

☒ GRAVITY ☐ PRESSURE

☒ Residence ☐ Business ☐ Other ☐ Slab ☐ Basement w/plumbing

No. Bedrooms 3 No. Persons No. Employees ☐ Crawl Space

Water Supply: ☒ Private ☐ Public ☐ Community

☐ Basement w/o plumbing

Comments / Conditions:

INITIAL SITE SKETCH

SEE PLAN FROM THE OAKS GROUP

AS BUILT SKETCH

Permit can be suspended or revoked if any false information is supplied toward securing the permit / any unauthorized changes are made to the site / any unauthorized changes are made in the installation of the system. **CONTACT A LOCATOR SERVICE PRIOR TO ANY EXCAVATION**


☐ **IMPROVEMENT PERMIT** *with plat valid without expiration.* ☐ **IMPROVEMENT PERMIT** *with site plan valid for 60 mos.* ☒ **AUTHORIZATION TO CONSTRUCT** *valid for period equal to IMPROVEMENT PERMIT--not to exceed 60 mo.*

Owner / Applicant Signature: Kathleen Saunders Date: 2-25-15 Installed by: ABERNATHY

IMPROVEMENT PERMIT by: APPROVED Date: FEB 23 2015 OPERATION PERMIT by: Date: 10-30-15

AUTHORIZATION TO CONSTRUCT by: APPROVED Date: FEB 23 2015 Existing System Inspected by: Date:

Health Dept. Copy - WHITE Applicant (Final Approval) - YELLOW Applicant (Conditional Approval) - PINK

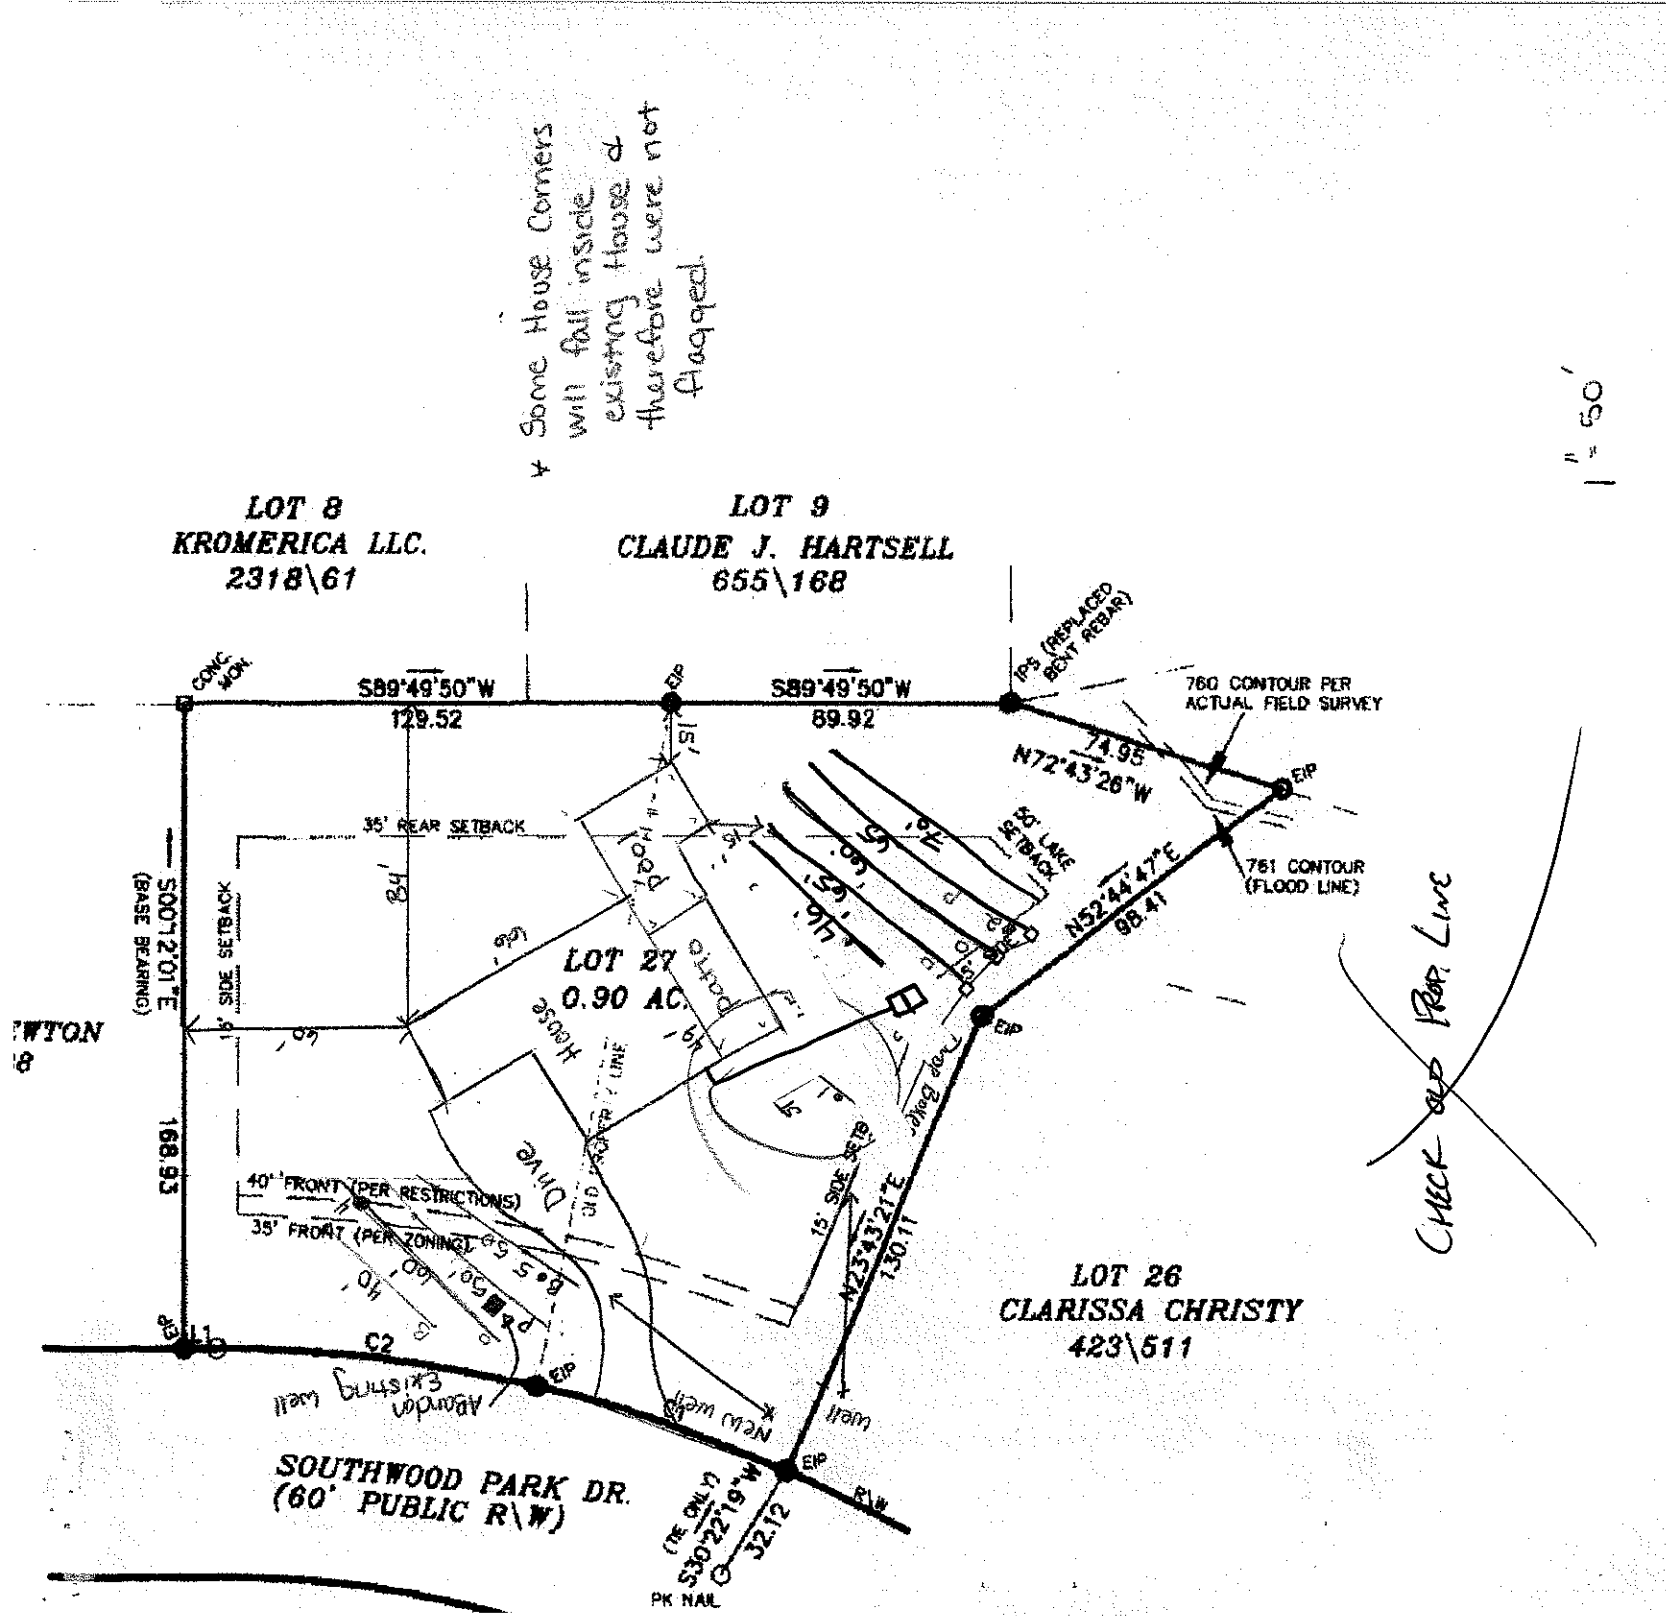

STATE OF NORTH CAROLIN
COUNTY OF IREDELL

I, William M. Alliso
COUNTY, CERTIFY THAT TH
WHICH THIS CERTIFICATION
ALL STATUTORY REQUIREMI

11-18-14
DATE

I, HEREBY CERTIFY THAT THI
AN EXCEPTION TO THE SUBD
COUNTY, NORTH CAROLINA.

William M. A
SUBDIVISION ADMINISTRATOR

IREDELL COUNTY, NORTH CA

THE LOT SHOWN ON THIS I
TO THE BEST OF MY KNOW
CRITICAL AREA WATERSHED
NORTH CAROLINA DIVISION
MANAGEMENT AND AS APP
WATERSHED PROTECTION M

11-18-14
DATE