IREDELL COUNTY HEALTH DEPARTMENT

STATESVILLE 704-878-5305 MOORESVILLE 704-664-5281

IMPROVEMENT PERMIT / AUTHORIZATION TO CONSTRUCT / OPERATION PERMIT / EXISTING SYSTEM INSPECTION

PERMIT# 87333 PIN# ~~4635590944~~ 4635-59-1792 DATE 2/9/00

OWNER OR CONTRACTOR JOYCE DRAPER PHONE: Business Home

ADDRESS 125 SOUTHWOOD PARK RD MOORESVILLE NC 28117

LOCATION BRAWLEY SCHOOL - IL STUTTS - TR SOUTHWOOD - ON RT # 125

SUBDIVISION MARINA VILLAGE BLOCK / SECTION LOT 49 LOT AREA SITE CLASS. PS DESIGN FLOW 360 L.T.A.R.

Septic Tank: 1500 Gallons; STB Date

Pump Tank: Gallons; PT Date

Pump Make: Model Serial No.

Nitrification Field: No Fields 1 Square Feet 600 960 Linear Feet 320

No Lines 3 Trench Width Max Trench Bottom Depth ~36" Gravel Depth 7

☑ New System ☐ Repair System Type: I, II, III, IV, V, VI

System Description: GRAVITY CONVENTIONAL

Repair System Description:

Maintenance Agreement Required: ☐ Yes ☑ No

☑ House/Mod. Home No. Bedrooms 3

☐ Mobile Home No. Bathrooms 2

☐ Business No. Employees

☐ Other

☐ Slab ☑ Crawl Space ☐ Basement w/plumbing ☐ Basement wo/plumbing


Water Supply: ☑ Individual ☐ Public ☐ Community

Comments:/Conditions:

EXISTING

Comments:/Conditions:

INITIAL SITE SKETCH

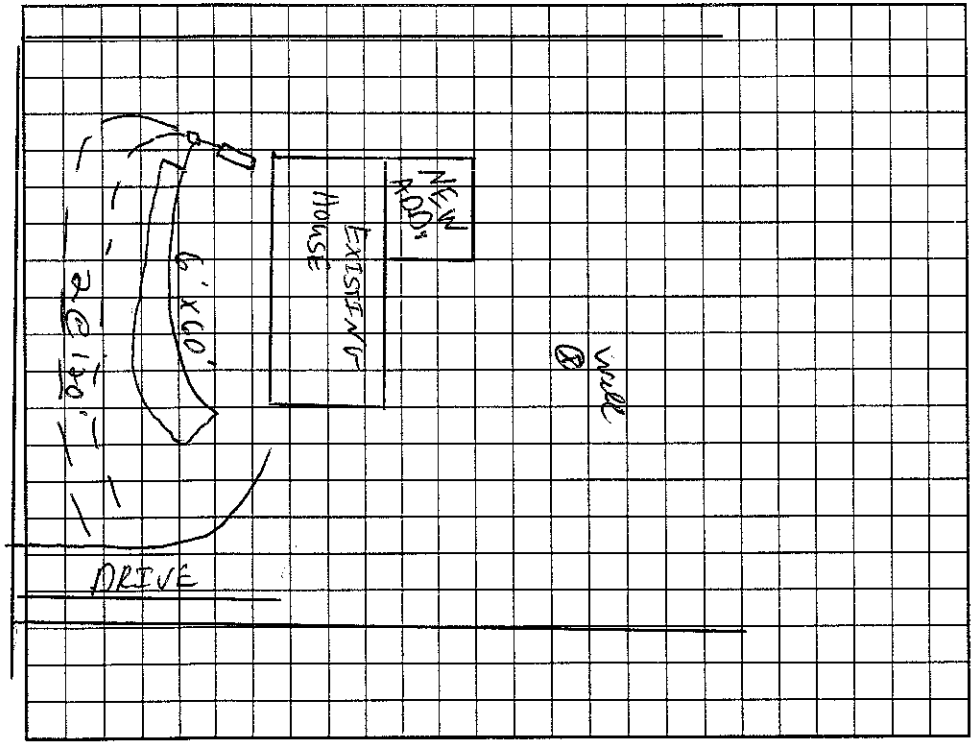

AS BUILT SKETCH

Permit can be suspended or revoked if any false information is supplied toward securing the permit/any unauthorized changes are made to the site/any unauthorized changes are made in the installation of the system. Improvement Permit with plat valid without expiration; Improvement Permit with site plan valid for sixty months. Authorization to Construct is valid for a period equal to that of Improvement Permit – not to exceed sixty months.

Signed: date 2.11.00 Installed by:

Improvement Permit by: date 2/9/00 Operation Permit by: date

Authorization to Construct by: date 2/9/00 Existing System Inspection by: PS date 2/9/00

HEALTH DEPT. COPY: WHITE OWNER COPY (FINAL): YELLOW OWNER COPY (INITIAL): PINK