IREDELL COUNTY HEALTH DEPARTMENT √→ [illegible]rization to Construct

STATESVILLE 704-878-5305 MOORESVILLE 704-664-5281

IMPROVEMENT PERMIT / ~~CERTIFICATE OF COMPLETION~~ / OPERATION PERMIT / EXISTING SYSTEM INSPECTION

PROPERTY DESCRIPTION NO. 23176 DATE 3/11/96 TAX MAP NO. 26-8-A-41 Watershed: ☐ Yes ☑ No

OWNER OR CONTRACTOR Sidney Blankenship ~~PHONE Business~~ 46 35-59-2413 Home 664-5350

ADDRESS 121 Crescent Pl Ln Mooresville NC 28115

LOCATION Brawley School Rd - TL Stutts Rd - TR Baywatch - TL Southwood - TL Crescent Ln.

SUBDIVISION Marina Village BLOCK / SECTION — LOT 4 LOT AREA 163 X 115 SITE CLASS. PS DESIGN FLOW 360gpd L.T.A.R. .35 gpd/ft²

Septic Tank: 1000 Gallons; STB 1012 Date 4/24/96

Pump Tank: ____ Gallons; PT ____ Date ____

Pump Make: ____ Model ____ Serial No. ____

Nitrification Field: No Fields 1 Square Feet 1028 Linear Feet 342

No Lines 6 Trench Width 36" Max Trench Bottom Depth 36" Gravel Depth 12"

☑ New System ☐ Repair System Type: I (II) III, IV, V, VI

System Description: Gravity Conventional

Repair System Description: Gravity Panel Block

Maintenance Agreement Required: ☐ Yes ☑ No

☐ Slab ☑ Crawl Space ☐ Basement w/plumbing ☐ Basement wo/plumbing

☑ House/Mod. Home No. Bedrooms 3

☐ Mobile Home No. Bathrooms 2

☐ Business No. Employees ____


☐ Other ____

Water Supply:
☑ Individual
☐ Community
☐ Public

Comments: Stay 50' away from neighbor's well with any part of septic system. Well shall be located at point referenced on permit.

Comments:

INITIAL SITE SKETCH

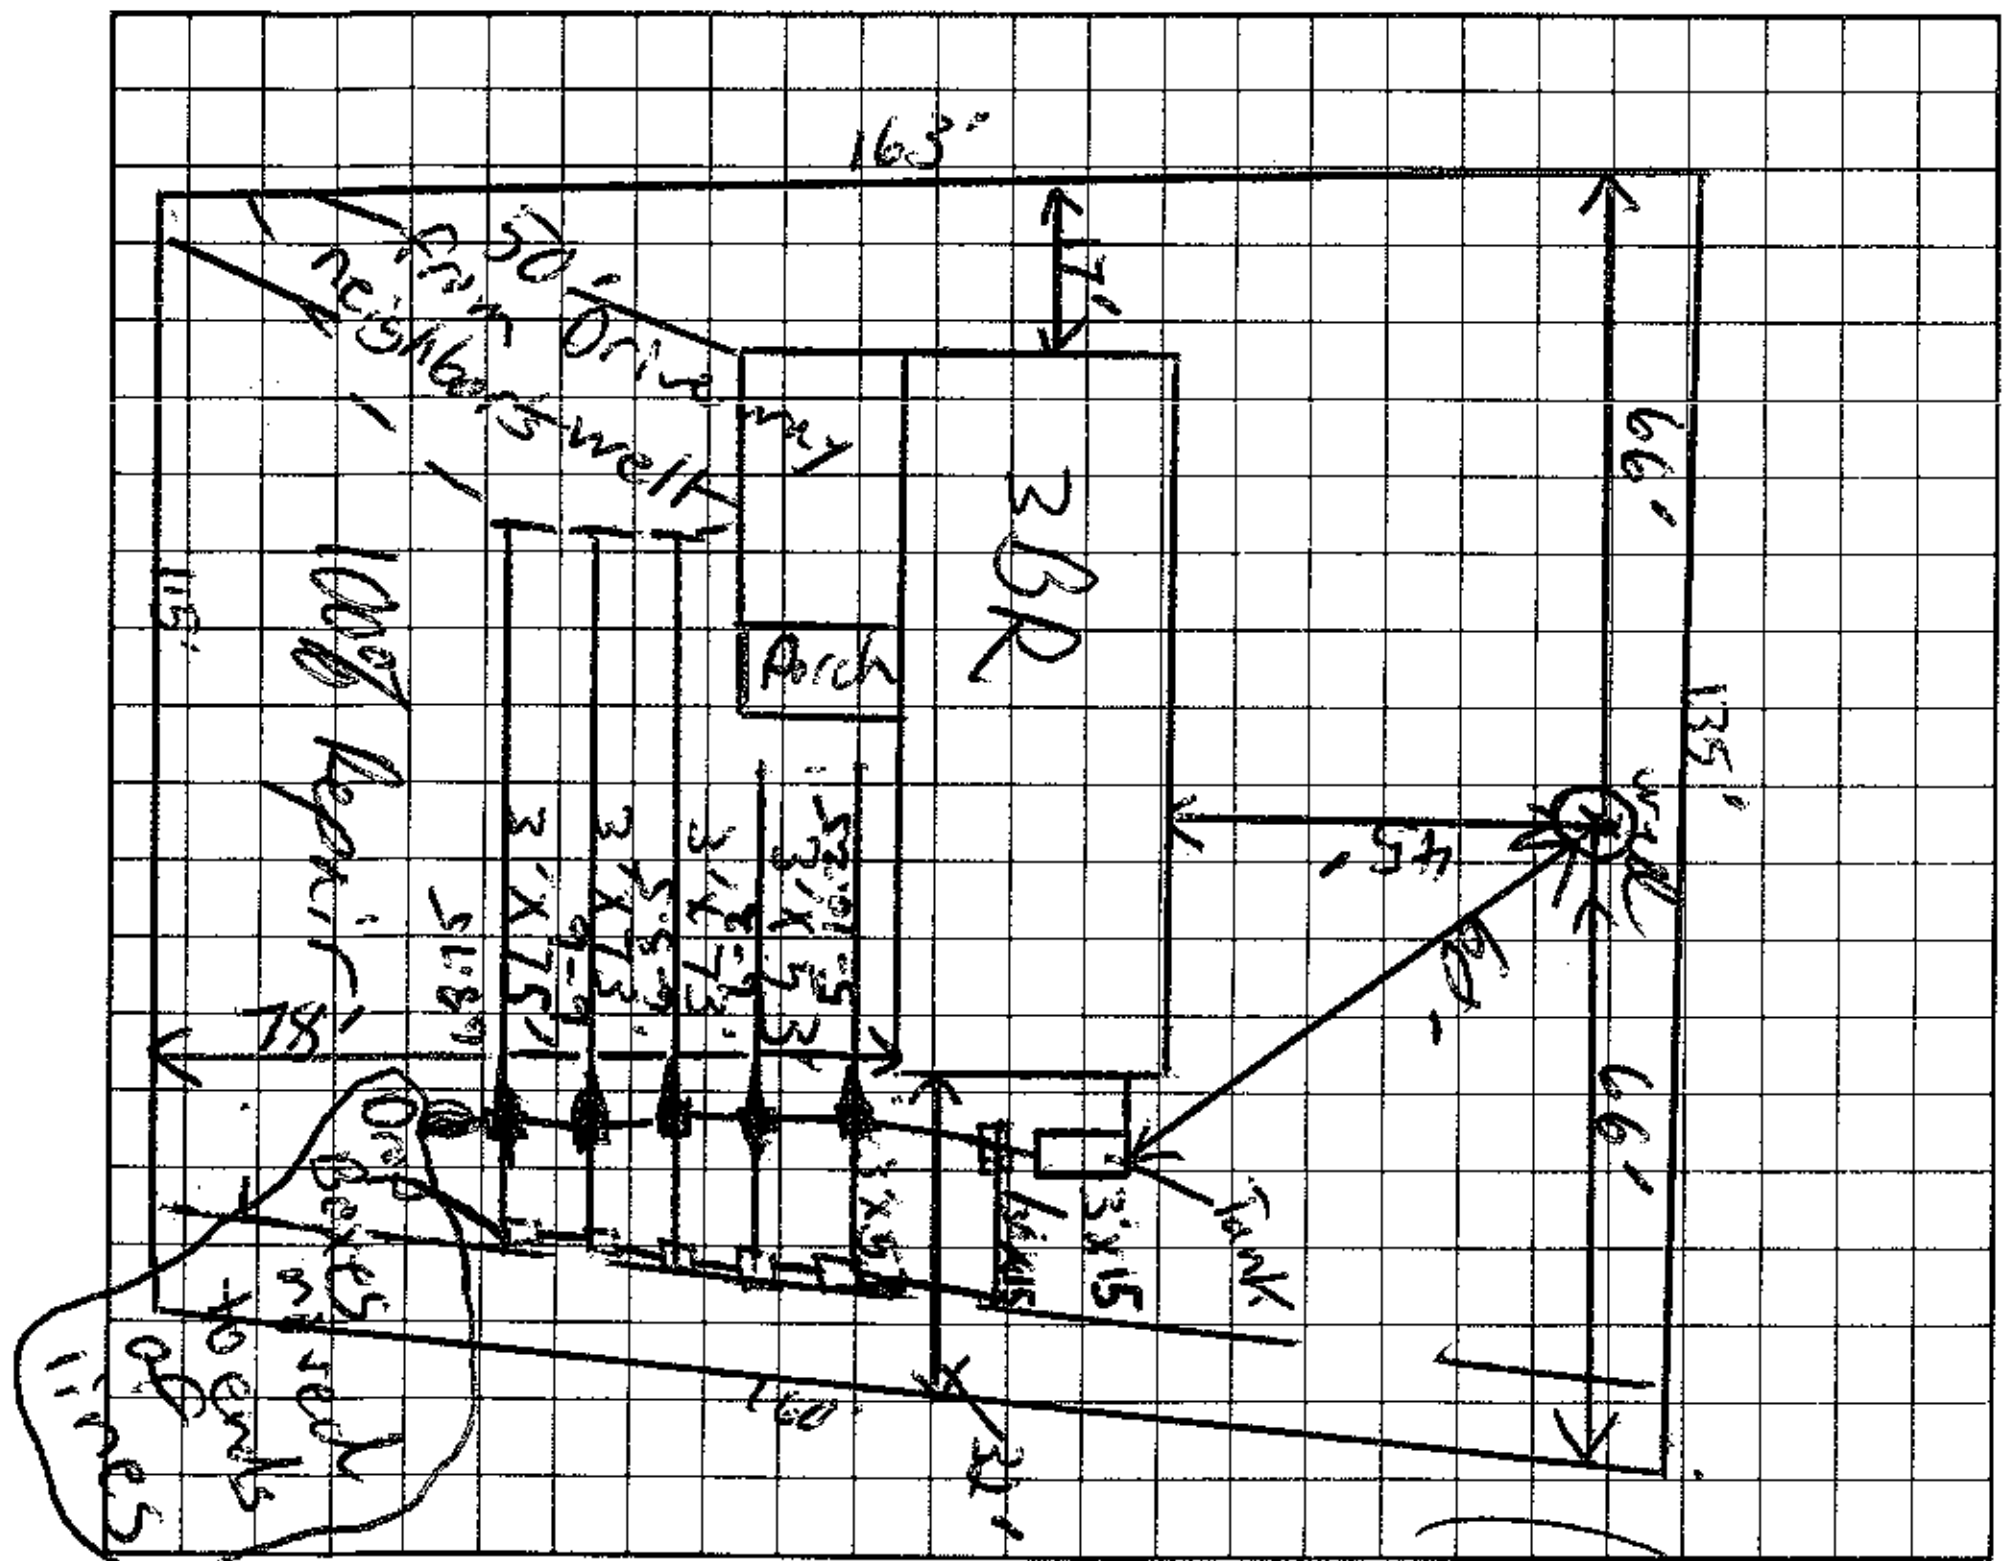

AS BUILT SKETCH

I understand that this permit can be suspended or revoked if any false information is supplied toward securing the permit/any unauthorized changes are made to the site/any unauthorized changes are made in the installation of the system.

Signed: X Sidney H. Blankenship

Improvement Permit by: C. Brady Freeman EHSI date 3/11/96

Authorization to construct ~~Existing System Inspection~~ by: C. Brady Freeman EHSI date 3/11/96

Installed by: Richard Abernathy

Certificate of Completion by: ____ date ____

Operation Permit by: Wesley Sparks RS. date 7/16/96

HEALTH DEPT. COPY: WHITE INSPECTION COPY (FINAL): GREEN OWNER COPY (FINAL): YELLOW INSPECTION COPY (INITIAL): PINK OWNER COPY (INITIAL): GOLD

Authorization to Construct expires 60 months from issue date. Improvements Permit does not expire.