IREDELL COUNTY HEALTH DEPARTMENT

AUTHORIZATION TO CONSTRUCT

STATESVILLE 704-878-5305 MOORESVILLE 704-664-5281

1:00

IMPROVEMENT PERMIT / ~~CERTIFICATE OF COMPLETION~~ / OPERATION PERMIT / EXISTING SYSTEM INSPECTION

PROPERTY DESCRIPTION NO. 066728 DATE 5/14/97 TAX MAP NO. 4635595405 & 4635596285 Watershed: ☑ Yes ☐ No

OWNER OR CONTRACTOR JAMES M FRANKLIN PHONE: Business _____ Home 704-664-3348

ADDRESS 484 STUTTS RD - MOORESVILLE NC 28115

LOCATION BRAWLEY SCHOOL RD - TL STUTTS RD - CORNER OF STUTTS RD & SOUTHWOOD PARK RD.

SUBDIVISION — BLOCK / SECTION — LOT — LOT AREA — SITE CLASS. 15 DESIGN FLOW 480GPD L.T.A.R. .30GPD/FT

Septic Tank: 1000 Gallons; STB 794 Date 7-22-97

Pump Tank: _____ Gallons; PT _____ Date _____

Pump Make: _____ Model _____ Serial No. _____

Nitrification Field: No Fields 1 Square Feet 1620 Linear Feet 520

No Lines 6 @ 90' Trench Width 36" Max Trench Bottom Depth 36" Gravel Depth 12"

☑ New System ☐ Repair System Type: I, II, III, IV, V, VI

System Description: GRAVITY CONVENTIONAL

Repair System Description: GRAVITY CHAMBERED OR SIMILAR

Maintenance Agreement Required: ☐ Yes ☑ No

☑ House/Mod. Home No. Bedrooms 4

☐ Mobile Home No. Bathrooms 4

☐ Business No. Employees _____

☐ Other _____


☐ Slab ☑ Crawl Space ☐ Basement w/plumbing ☐ Basement wo/plumbing

Water Supply: ☑ Individual ☐ Community ☐ Public


Comments: (SHOULD BE 540')

Comments: Installed as Drawn

INITIAL SITE SKETCH

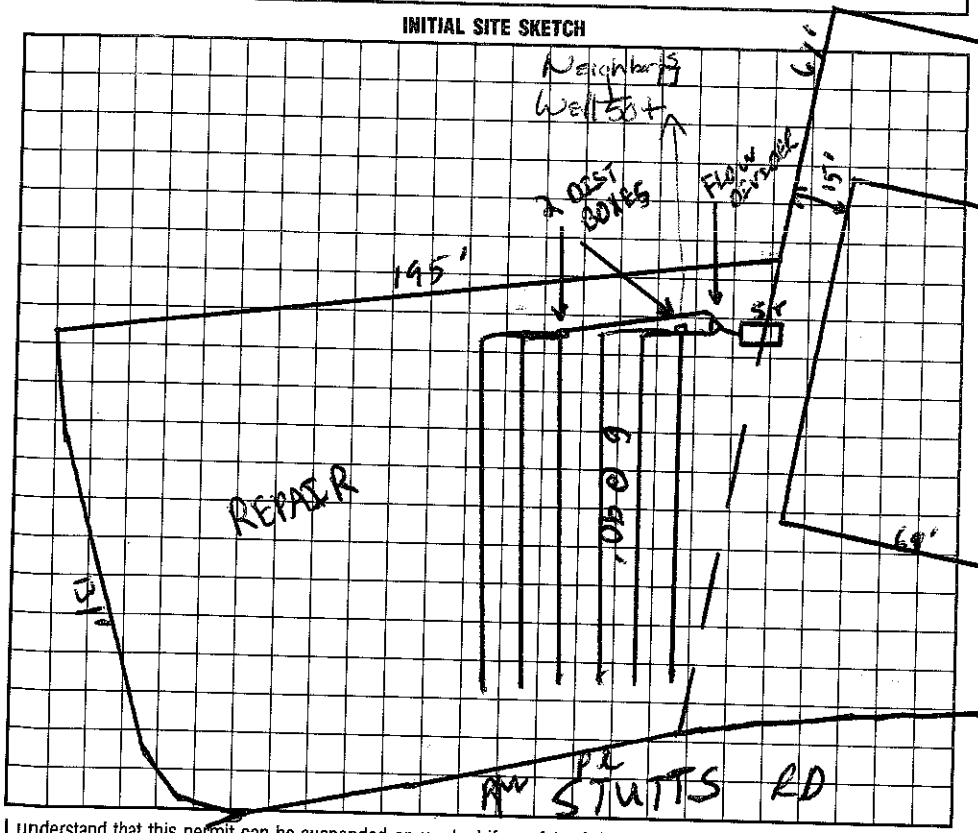

AS BUILT SKETCH

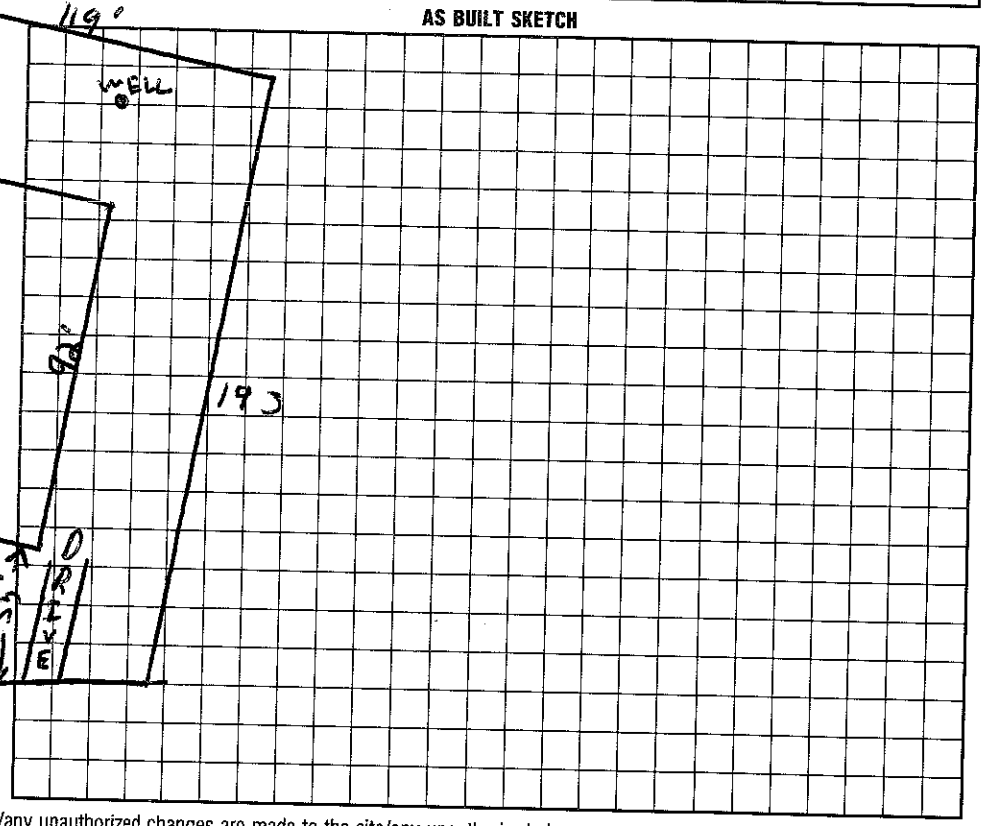

I understand that this permit can be suspended or revoked if any false information is supplied toward securing the permit/any unauthorized changes are made to the site/any unauthorized changes are made in the installation of the system. Improvement Permit is valid for 60 months from date of issuance.

Signed: _____

Improvement Permit by: AUTHORIZATION C. Ray Teem date 5/14/97

Existing System Inspection by: CONSTRUCT C. Ray Teem date 5/14/97

Installed by: Curt Dunning

Certificate of Completion by: Marie H. H. Dotson date 10/16/97

Operation Permit by: Marie H. H. Dotson date 10/16/97

HEALTH DEPT. COPY: WHITE INSPECTION COPY (FINAL): GREEN OWNER COPY (FINAL): YELLOW INSPECTION COPY (INITIAL): PINK OWNER COPY (INITIAL): GOLD