IREDELL COUNTY HEALTH DEPARTMENT
Authorization to Construct

STATESVILLE 704-878-5305 MOORESVILLE 704-664-5281

IMPROVEMENT PERMIT / ~~CERTIFICATE OF COMPLETION~~ / OPERATION PERMIT / EXISTING SYSTEM INSPECTION

PROPERTY DESCRIPTION NO. 066764 DATE 5/5/97 TAX MAP NO. 4635597010 Watershed: ☒ Yes ☐ No

OWNER OR CONTRACTOR Robert K Harris PHONE: Business ______ Home 664-7661 (892-0161)

ADDRESS 128 Southwood Park Rd. Mooresville, NC 28115

LOCATION Brawley Sch. TL Stutts Rd TR Southwood Park Rd., 2nd lot on (L)

SUBDIVISION MARINA VILLAGE BLOCK / SECTION ______ LOT 33 LOT AREA .5 AC SITE CLASS. PS DESIGN FLOW 360 L.T.A.R. .3

Septic Tank: 1000 Gallons; STB 994 Date 9/22/97
Pump Tank: ______ Gallons; PT ______ Date ______
Pump Make: ______ Model ______ Serial No. ______
Nitrification Field: No Fields 1 Square Feet 900* Linear Feet 300*
No Lines 5 Trench Width 36" Max Trench Bottom Depth 36" Gravel Depth SAND

☒ New System ☐ Repair System Type: I, II, (III), IV, V, VI
System Description: GRAV - CH PLASTIC
Repair System Description: SAME
Maintenance Agreement Required: ☐ Yes ☐ No
☐ Slab ☒ Crawl Space ☐ Basement w/plumbing ☐ Basement wo/plumbing


☒ House/Mod. Home No. Bedrooms 3
☐ Mobile Home No. Bathrooms 2
☐ Business No. Employees ______
☐ Other

Water Supply:
☒ Individual
☐ Community
☐ Public


Comments:

Comments:

INITIAL SITE SKETCH

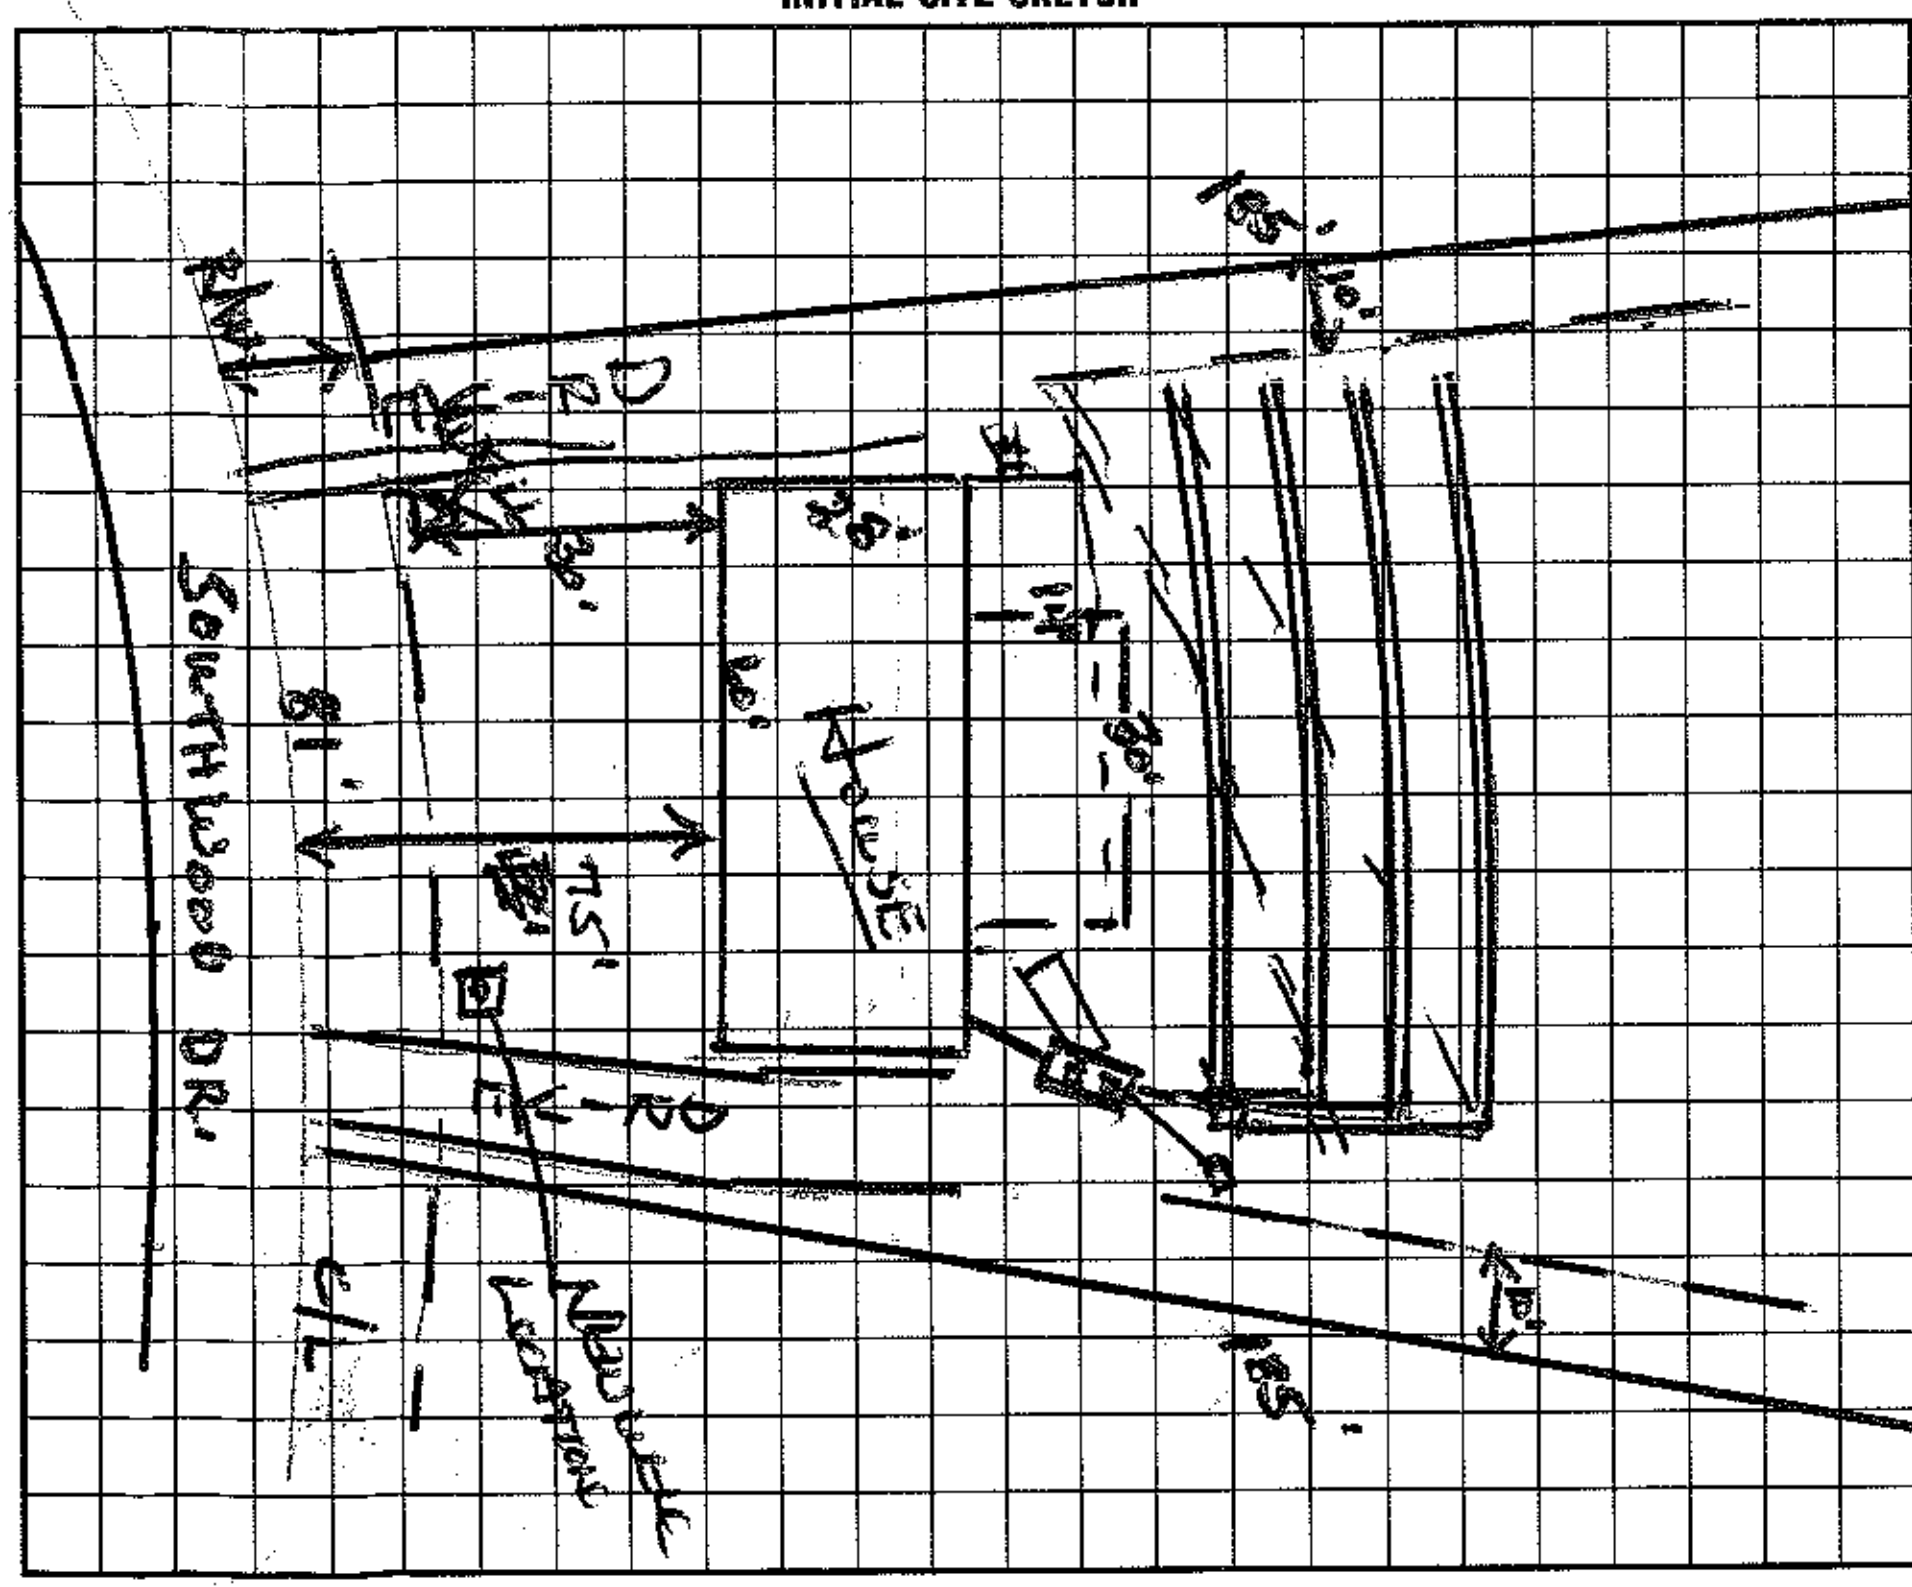

AS BUILT SKETCH

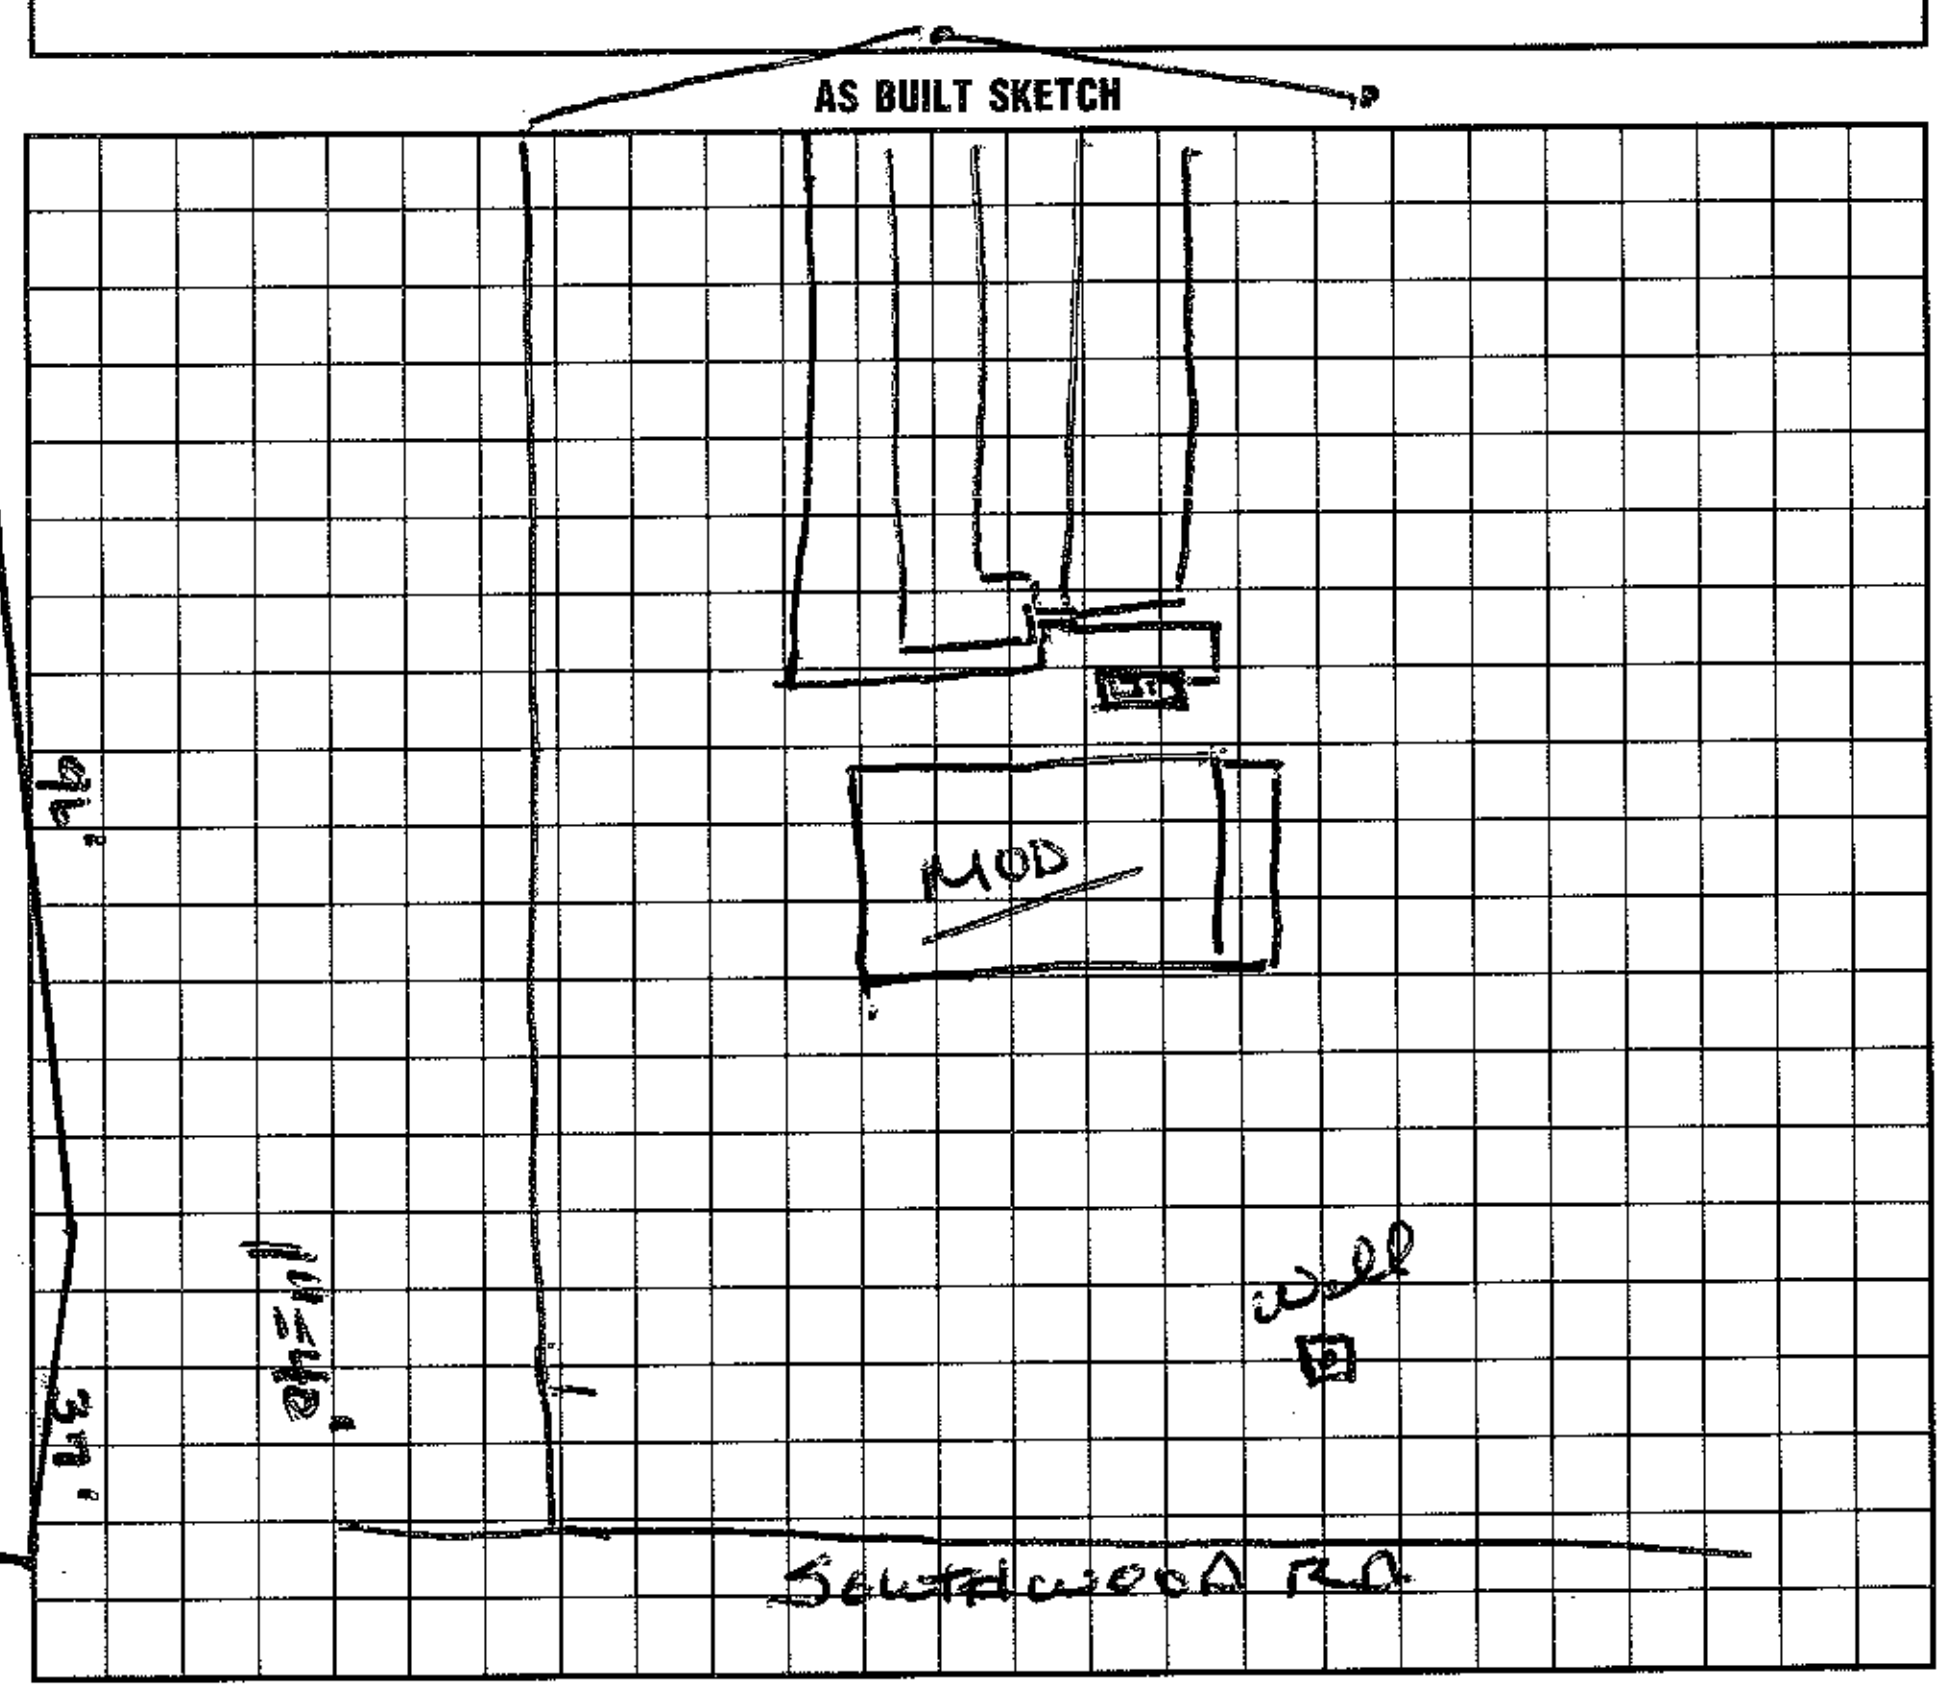

I understand that this permit can be suspended or revoked if any false information is supplied toward securing the permit/any unauthorized changes are made to the site/any unauthorized changes are made in the installation of the system. Improvement Permit is valid for 60 months from date of issuance.

Signed: X Robert K Harris

Improvement Permit by: Wesley Sparks R.S. date 5/5/97

~~Existing System Inspection~~ Auth. Const. by: Wesley Sparks R.S. date 5/5/97

Installed by: Curt Dunning

Certificate of Completion by: Wesley Sparks R.S. date 12/3/97

Operation Permit by: Wesley Sparks R.S. date 12/3/97

HEALTH DEPT. COPY: WHITE INSPECTION COPY (FINAL): GREEN OWNER COPY (FINAL): YELLOW INSPECTION COPY (INITIAL): PINK OWNER COPY (INITIAL): GOLD