IREDELL COUNTY HEALTH DEPARTMENT

STATESVILLE 704-878-5305 MOORESVILLE 704-664-5281

IMPROVEMENT PERMIT / AUTHORIZATION TO CONSTRUCT / OPERATION PERMIT / EXISTING SYSTEM INSPECTION

PERMIT# 144157 PIN# 4635598014 DATE 7-27-07

OWNER OR APPLICANT Peter Gjuraj PHONE: Business _____ Home _____

ADDRESS 19905 W Catawba Ave Cornelius NC 28031

LOCATION Brawley School Rd TL Stutts at corner of Southwood Park Address: 208 Southwood Park

SUBDIVISION Marina Village BLOCK / SECTION _____ LOT 34 LOT AREA .456 Ac SITE CLASS. PS DESIGN FLOW 480gpd L.T.A.R. .3 gpd/ft²

Septic Tank: 1000 Gallons; STB 794 Date 11/9/07

Pump Tank: 1000 Gallons; PT 283 Date 11/4/07

Pump Make Gorman Model NEOS11HH Serial No 8076210?

Nitrification Field: No Fields 1 Square Feet _____ Linear Feet 400

No Lines 5 @ 80' Trench Width 36" Max Trench Bottom Depth 36"

☒ New System ☐ Repair ☐ Expansion System Type: I II III IV V VI

System Description: 2590 reduction pm

Repair System Description: LPP PBPS Max. Feasible Rule .1945

Maintenance Agreement Required: ☐ Yes ☒ No

☒ House/Mod. Home ☐ Mobile Home ☐ Business ☐ Other

No. Bedrooms 4 No. Persons 8 No. Employees ____


Water Supply: ☒ Individual ☐ Public ☐ Community

Gravel Depth NA ☐ Gravity ☒ Pressure ☐ Slab ☒ Crawl Space ☐ Basement w/plumbing ☐ Basement wo/plumbing

Comments/Conditions: mark corner radius of property line before installation well 50' setback from repair

Comments/Conditions: 1/4/08 Tanks, lines & pressure 2/6/09 Checked elect & alarm

INITIAL SITE SKETCH

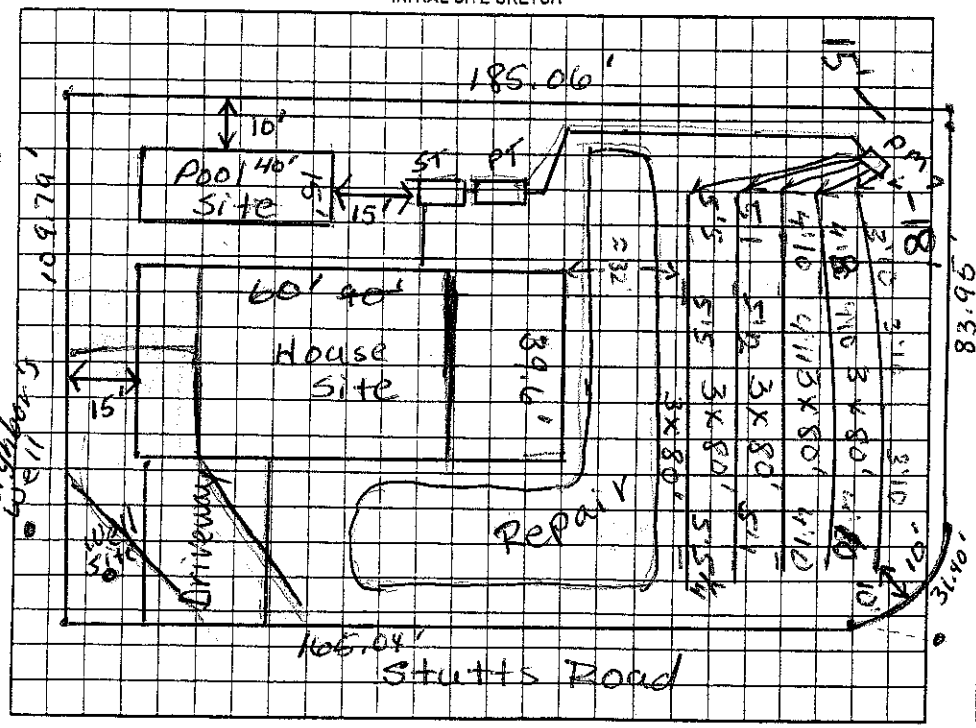

AS BUILT SKETCH

System installed as designed

No home onsite at inspection 1/4/08

Quick 4

Permit can be suspended or revoked if any false information is supplied toward securing the permit/any unauthorized changes are made to the site/any unauthorized changes are made in the installation of the system. Improvement Permit with plat valid without expiration ☐ Improvement Permit with site plan valid for sixty months ☒ Authorization to Construct is valid for a period equal to that of Improvement Permit - not to exceed sixty months.

Signed: Peter Gjuraj date _____

Improvement Permit by: Judy Melville date 7-30-07

Authorization to Construct by: Judy Melville date 12-19-07

Installed by: A-1 Backhoe

Operation Permit by: [signature] date 2/6/09

Existing System Inspection by: _____ date _____

HEALTH DEPT. COPY: WHITE OWNER COPY (FINAL): YELLOW OWNER COPY (INITIAL): PINK