704 832 1842

IREDELL COUNTY HEALTH DEPARTMENT

STATESVILLE 704-878-5305 MOORESVILLE 704-66[redacted]

IMPROVEMENT PERMIT / AUTHORIZATION TO CONSTRUCT / OPERATION PERMIT / EXISTING SYSTEM INSPECTION

PERMIT# 144157 PIN# 4635598014 DATE 7-27-07

OWNER OR APPLICANT Peter Gjuraj PHONE: Business _____ Home _____

ADDRESS 19905 W Catawba Ave Cornelius NC 28031

LOCATION Brawley School Rd TL Stutts at corner of Southwood Park Address: 208 Southwood Park

SUBDIVISION Marina Village BLOCK / SECTION _____ LOT 34 LOT AREA: .456 Ac SITE CLASS. PS DESIGN FLOW 480gpd L.T.A.R. .3 gpd/ft²

Septic Tank: 1000 Gallons; STB 794 Date 11/9/07
Pump Tank: 1000 Gallons; PT 283 Date 11/14/07
Pump Make Goulds Model VEO511HH Serial No. D676-102
Mitification Field: No Fields 1 Square Feet _____ Linear Feet 400
No Lines 5 @ 80' Trench Width 36" Max Trench Bottom Depth 36"

☒ New System ☐ Repair ☐ Expansion System Type: I II III IV V VI
System Description: 2590 reduction rpm
Repair System Description: LP PPBPS Max. Feasible Rule .1945
Maintenance Agreement Required: ☐ Yes ☒ No

☒ House/Mod. Home ☐ Mobile Home ☐ Business ☐ Other
No. Bedrooms 4 No. Persons 8 No. Employees _____


Water Supply: ☒ Individual ☐ Public ☐ Community

Gravel Depth N/A ☐ Gravity ☒ Pressure ☐ Slab ☒ Crawl Space ☐ Basement w/plumbing ☐ Basement wo/plumbing


Comments/Conditions:
Mark corner radius of property line before installation
Well 50' setback from repair

Comments/Conditions:
1/4/08 Tanks, lines & pressure
2/6/09 Checked elect & alarm

INITIAL SITE SKETCH

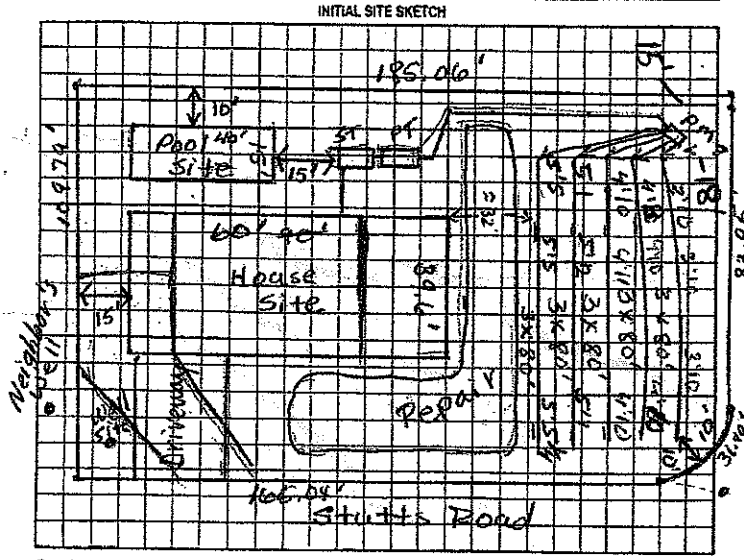

AS BUILT SKETCH

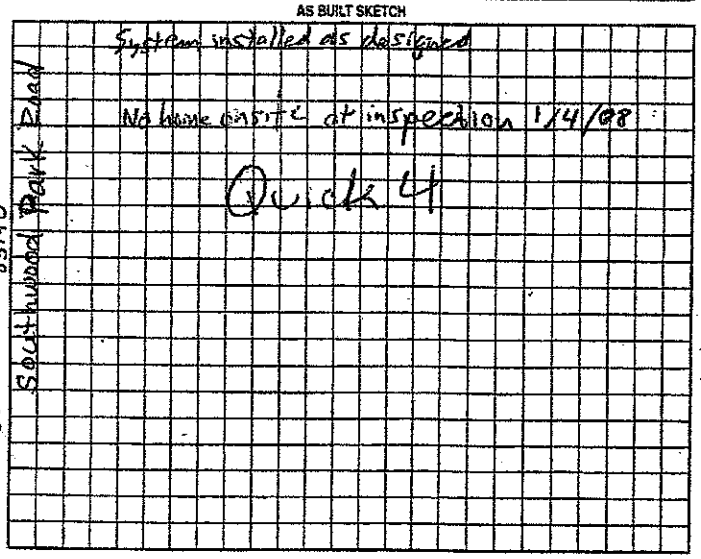

Permit can be suspended or revoked if any false information is supplied toward securing the permit/any unauthorized changes are made to the site/any unauthorized changes are made in the installation of the system. Improvement Permit with plat valid without expiration ☐ Improvement Permit with site plan valid for sixty months ☒ Authorization to Construct is valid for a period equal to that of Improvement Permit - not to exceed sixty months.

Signed: Peter Gjuraj date _____

Improvement Permit by: Judy Melville date 7-30-07

Authorization to Construct by: Judy Melville date 12-19-07

Installed by: A-1 Backhoe

Operation Permit by: [signature] date 2/6/09

Existing System Inspection by _____ date _____

HEALTH DEPT. COPY: WHITE OWNER COPY (FINAL): YELLOW OWNER COPY (INITIAL): PINK

The location of the proposed Pool addition does not appear to impact the existing septic system.
**NOTE: Shall be min. 15' from septic tank

Judy Melville REHS
Date: 02-10-12
ICHD-Environmental Health Division