4635 60 4038

# IREDELL COUNTY HEALTH DEPARTMENT

STATESVILLE 704-878-5305 MOORESVILLE 704-664-5281

## IMPROVEMENT PERMIT / CERTIFICATE OF COMPLETION / OPERATION PERMIT / EXISTING SYSTEM INSPECTION

PROPERTY DESCRIPTION NO. 17923 DATE March 8, 94 TAX MAP NO. 2B2A11 Watershed: ☑ Yes ☐ No

OWNER OR CONTRACTOR Paul Cedrone / Dorlin Kerr PHONE: Business 663-6533 Home L.N.

ADDRESS

LOCATION 1102, TR Schooner TR Flying Scott Ct., at END on/off

SUBDIVISION Sailor's Lair BLOCK / SECTION LOT 11 LOT AREA SITE CLASS. DESIGN FLOW L.T.A.R.

Septic Tank: Existing Gallons; STB Date

Pump Tank: Gallons; PT Date

Pump Make: Model Serial No.

Nitrification Field: No Fields Square Feet Linear Feet

No Lines Trench Width Max Trench Bottom Depth Gravel Depth

☐ New System ☑ Repair System Type: I, II, III, IV, V, VI

System Description: gravity conventional

Repair System Description:

Maintenance Agreement Required: ☐ Yes ☐ No

☑ House/Mod. Home No. Bedrooms 3

☐ Mobile Home No. Bathrooms 2½

☐ Business No. Employees

☐ Other


☐ Slab ☑ Crawl Space ☐ Basement w/plumbing ☐ Basement wo/plumbing

Water Supply: ☑ Individual ☐ Community ☐ Public


Comments: Existing system showing no sign of malfunction, office-sitting room addition does not required upgrading of septic system; however owner desires to add to septic system due to its age and while his yard is a "mess".

Comments:

INITIAL SITE SKETCH

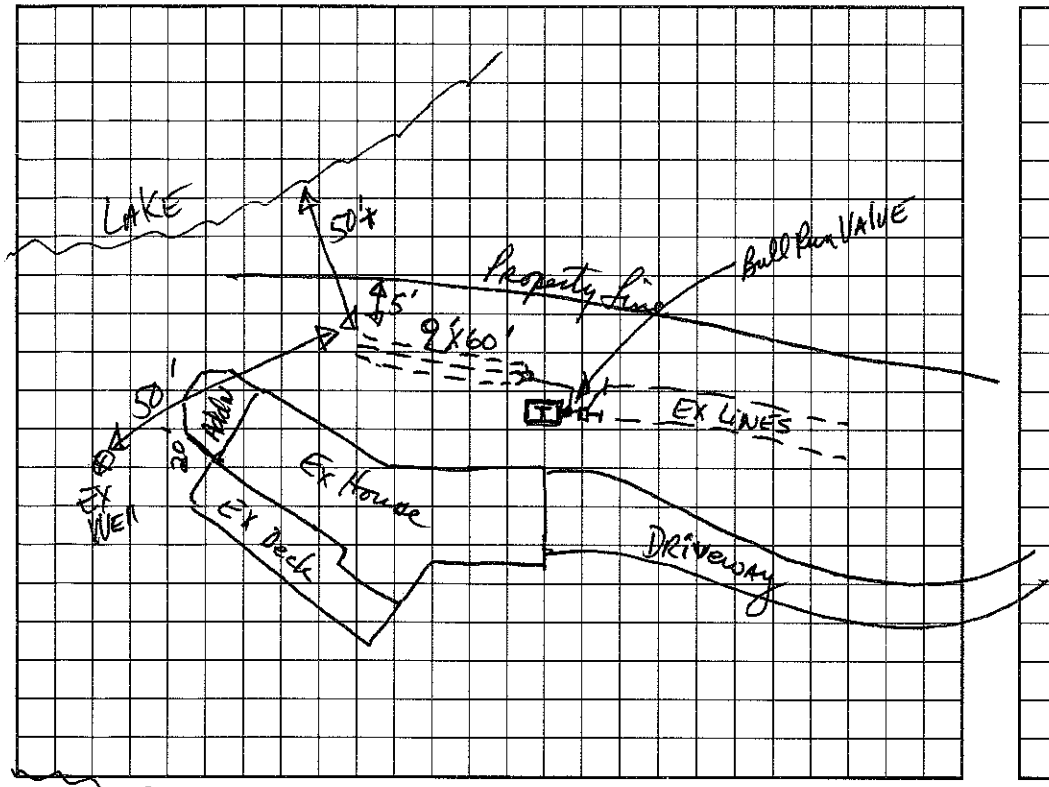


AS BUILT SKETCH

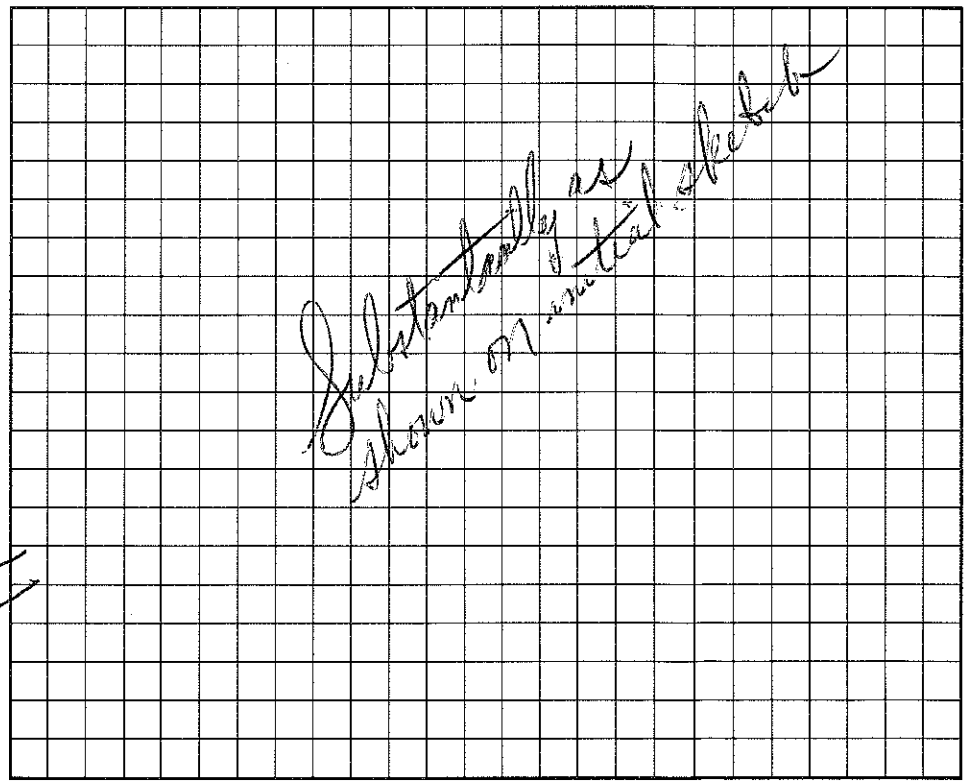

I understand that this permit can be suspended or revoked if any false information is supplied toward securing the permit/any unauthorized changes are made to the site/any unauthorized changes are made in the installation of the system. Improvement Permit is valid for 60 months from date of issuance.

Signed:

Improvement Permit by: Jack K. Hinson, RS date 3/8/94

Existing System Inspection by: date

Installed by: J.R. Bowles

Certificate of Completion by: Jack K. Hinson RS date 6/22/94

Operation Permit by: date

HEALTH DEPT. COPY: WHITE INSPECTION COPY (FINAL): GREEN OWNER COPY (FINAL): YELLOW INSPECTION COPY (INITIAL): PINK OWNER COPY (INITIAL): GOLD