IREDELL COUNTY HEALTH DEPARTMENT

Statesville Office (704) 878-5305 Mooresville Office (704) 660-3625 PERMIT # 210934

IMPROVEMENT PERMIT / AUTHORIZATION TO CONSTRUCT / OPERATION PERMIT / EXISTING SYSTEM

PIN # 4635680010

APPLICANT: Charles Norton APPLICANT ADDRESS: 342 Shoreline Lp Mooresville NC 28117

SITE ADDRESS: 342 Shoreline Lp PHONE: ALT. PHONE: 704 360 9547

SITE DIRECTIONS: Brawley School Rd R Stotts Rd to end TR Shoreline Lp on left #342

SUBDIVISION: Imperial Pt SECTION: LOT # 34/35 LOT AREA: .894 Ac DESIGN FLOW: 240 gpd L.T.A.R.:

Septic Tank Exist (gal) STB Date
Pump Tank (gal) PT Date
Pump Make Model Serial #
Nitrification Fields 1 # Lines Linear Ft 255
Trench Width Bed 7½x85 Max Trench Bottom Depth Gravel Depth


☐ New System ☐ Repair ☐ Expansion System Type: ☐ II ☐ III ☐ IV ☐ V ☐ VI
System Description: Exist Granty Conventional Bed
Repair System Description: at Deeded recorded prior to
Maintenance Agreement Required: ☐ YES ☒ NO 1983
☒ GRAVITY ☐ PRESSURE

☒ Residence No. Bedrooms 2
☐ Business No. Persons 4
☐ Other No. Employees
☐ Slab ☐ Crawl Space
☐ Basement w/plumbing ☐ Basement w/o plumbing


Water Supply: ☒ Private ☐ Public ☐ Community

Comments / Conditions: The proposed Garage/Hangar does not appear to impact the existing Septic System meets setbacks to well & Septic

INITIAL SITE SKETCH

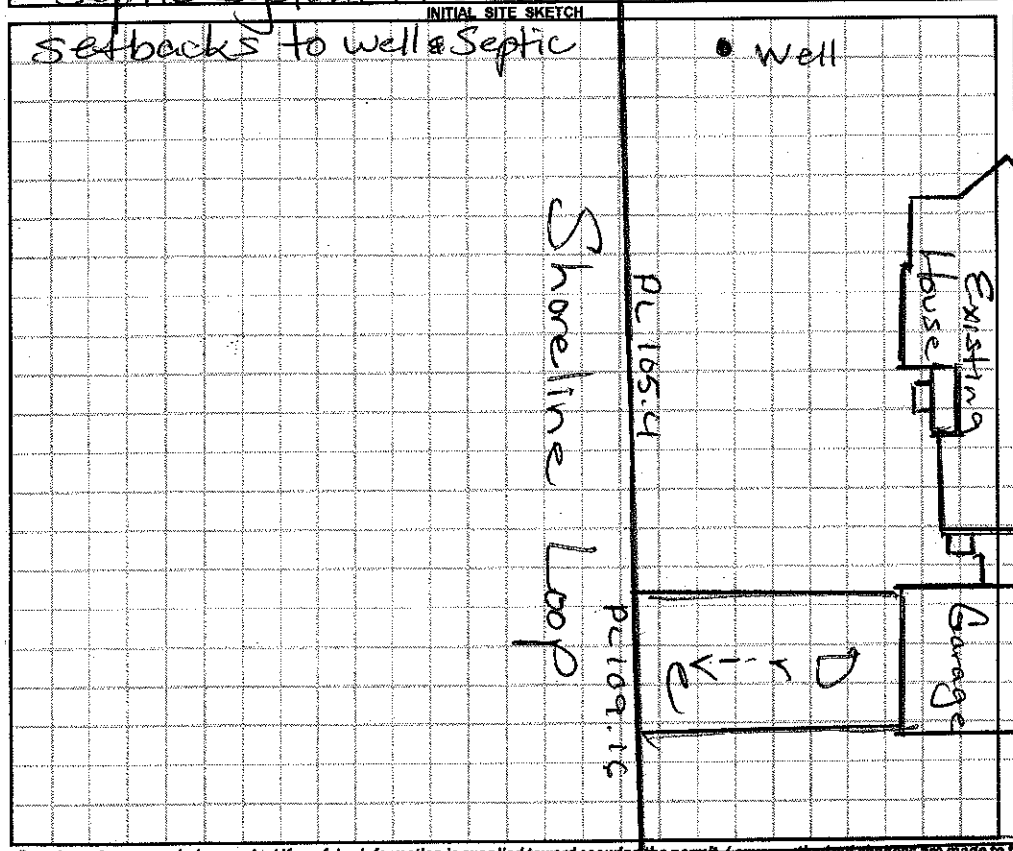

AS BUILT SKETCH

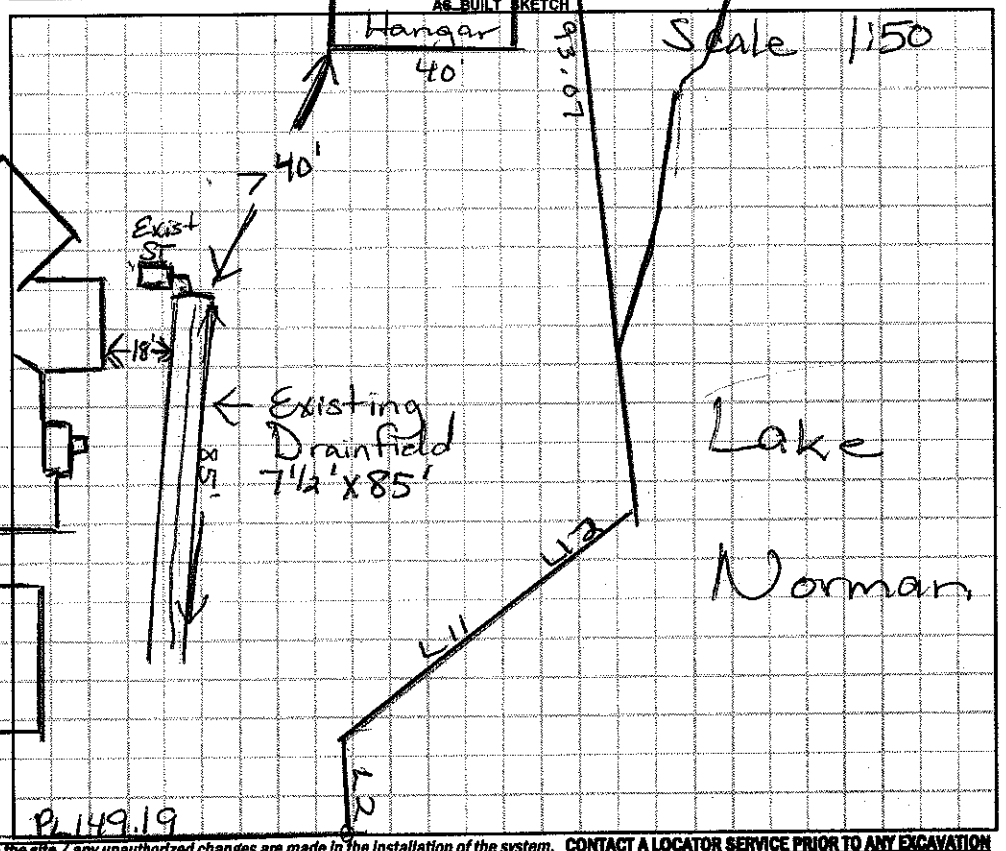

Permit can be suspended or revoked if any false information is supplied toward securing the permit, any unauthorized changes are made to the site / any unauthorized changes are made in the installation of the system. **CONTACT A LOCATOR SERVICE PRIOR TO ANY EXCAVATION**

☐ **IMPROVEMENT PERMIT** *with plat valid without expiration.* ☐ **IMPROVEMENT PERMIT** *with site plan valid for 60 mos.* ☐ **AUTHORIZATION TO CONSTRUCT** *valid for period equal to IMPROVEMENT PERMIT--not to exceed 60 mo.*

Owner / Applicant Signature: Date: 6-30-15 Installed by:

IMPROVEMENT PERMIT by: Date: OPERATION PERMIT by: Date:

AUTHORIZATION TO CONSTRUCT by: Date: Existing System Inspected by: Maria Dotson RS Date: 6/22/15

Health Dept. Copy - WHITE Applicant (Final Approval) - YELLOW Applicant (Conditional Approval) - PINK