IREDELL COUNTY HEALTH DEPARTMENT

FILE COPY

ENVIRONMENTAL HEALTH DIVISION


PAGE 2: *SITE PLAN WORKSHEET*


SEE THE "SAMPLE SITE PLAN" BELOW. ***INCOMPLETE SITE PLANS WILL BE RETURNED TO YOU FOR COMPLETION AND MAY RESULT IN A DELAY IN THE ISSUANCE OF YOUR SEPTIC SYSTEM PERMIT!!!***

Place an (X) beside each item as you complete the site plan:

( ) Property Line measurements are clearly identified
( ) All proposed structures are indicated
( ) Front and side setbacks from property line
( ) Preferred driveway location and well location
( ) Area you prefer your septic system to be placed
( ) North arrow, or other sufficient indicator of direction

Circle N/A on the following if appropriate:

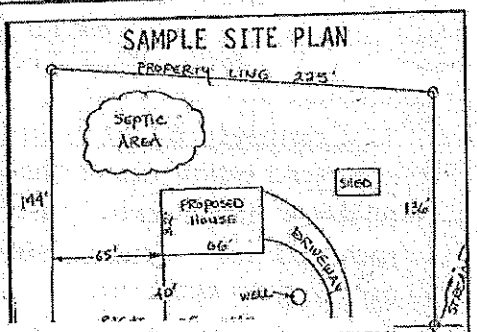

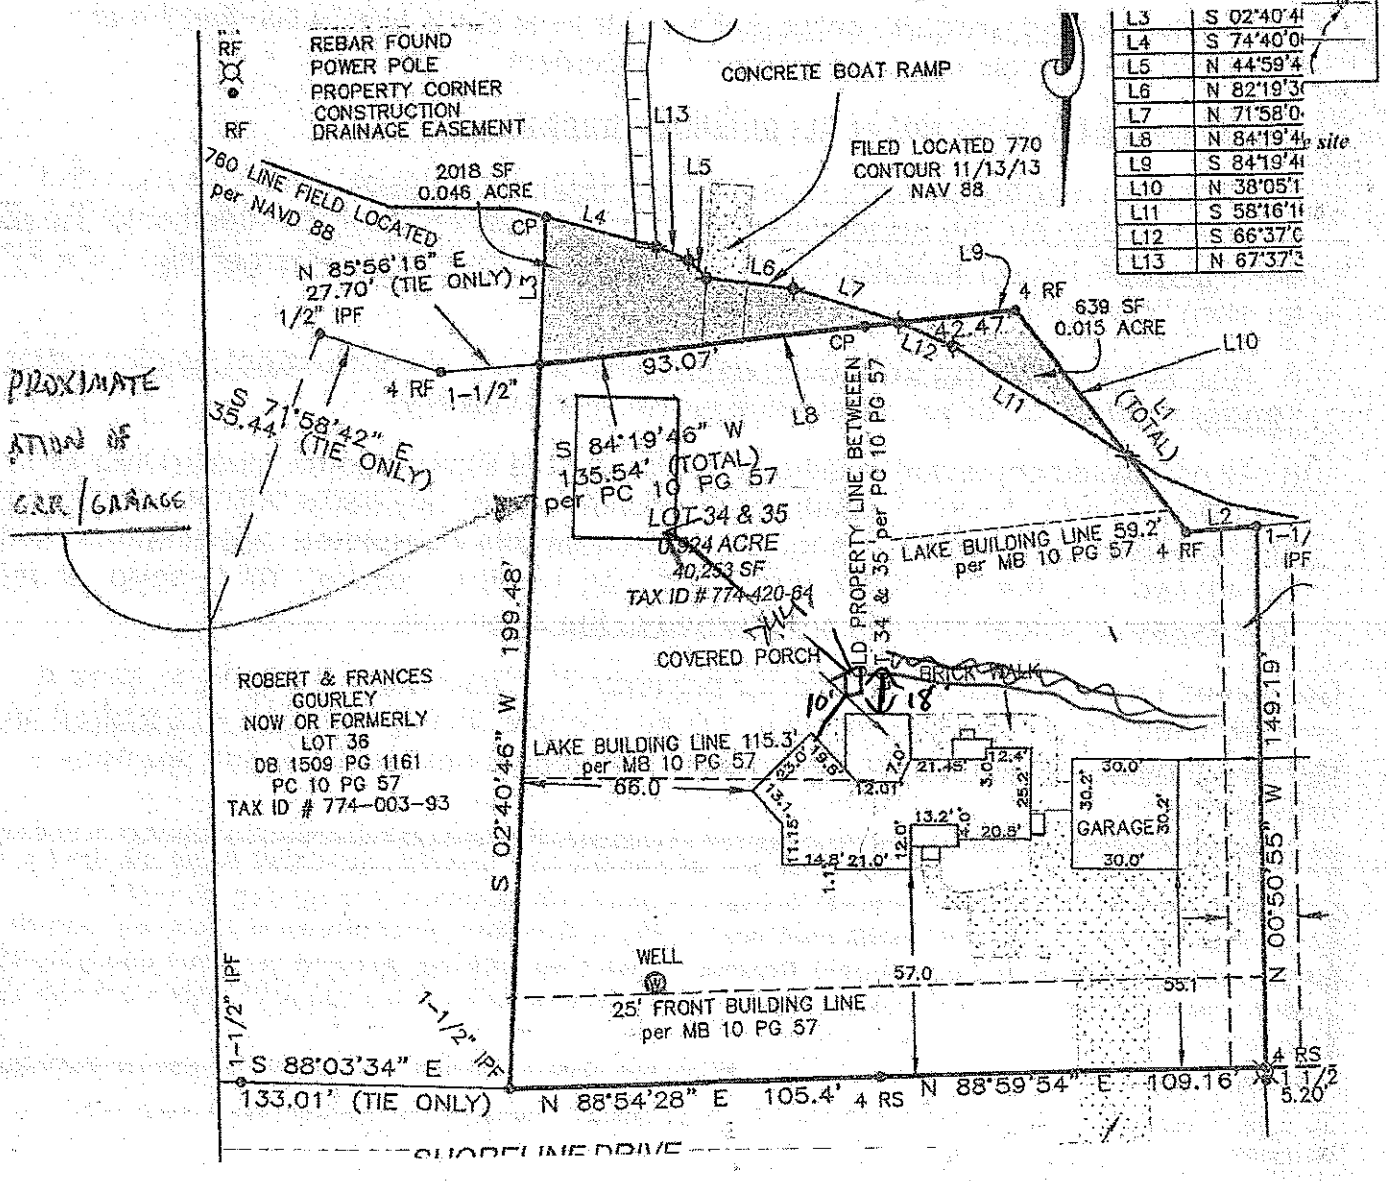

PROXIMATE ATION OF CAR/GARAGE

Signature: _____

Property owner or owner's legal representative signature (SIGNATURE REQUIRED)

1 Jan 15

DATE

4635 680010

IREDELL COUNTY HEALTH DEPARTMENT

Statesville Phone TR 3-7271 Mooresville Phone No. 664-5281

PERMIT TO INSTALL SEPTIC TANK

Permit No. 67 Permit Date 5-3- 1973

Owner Mr. Mullis Address Charlotte

Installed By Don Lackey Address Stoney Point


Location of Property 1100 ft on 112 at end TR 2nd House on left Lots 34 & 35 Imperial Pt.

Tank		Capacity		Length of Lines		Fixtures	
Block	( )	1000	( )	225'	( )	No. of Baths	(2)
Precast	(✓)	1250	(✓)	250'	( )	Dishwasher	(yes
		1500	( )	Other 255		Garbage Grdr.	yes
		Other				Other Washing Machine	

NOTIFY HEALTH DEPARTMENT AT LEAST EIGHT HOURS BEFORE TANK IS TO BE INSPECTED.

Final Inspection 5-3- 1973 Approved (✓) Disapproved ( )

Remarks

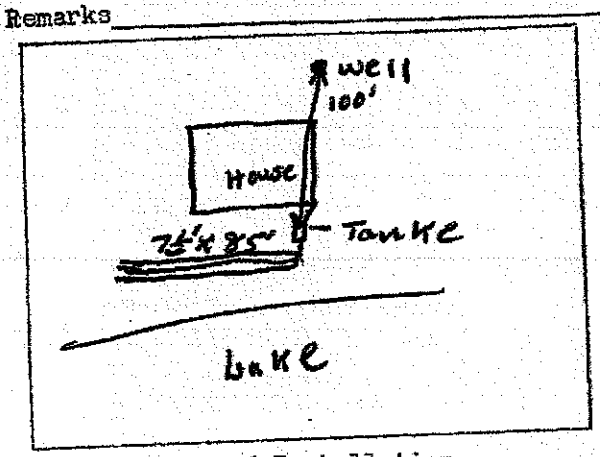

Sketch of Installation

J. C. Moore
Sanitarian

2 Bedrooms