IREDELL COUNTY HEALTH DEPARTMENT

Authorization to Construct

STATESVILLE 704-878-5305 MOORESVILLE 704-664-5281

IMPROVEMENT PERMIT / ~~CERTIFICATE OF COMPLETION~~ / OPERATION PERMIT / EXISTING SYSTEM INSPECTION

PROPERTY DESCRIPTION NO. 22282 DATE 11/21/95 TAX MAP NO. 2G 14A 42 Watershed: [X] Yes [ ] No

OWNER OR CONTRACTOR Allen McKinney PHONE: Business 598-6500 Home

ADDRESS ~~1970 Hwy~~ 8323H Harris Pond Charlotte, NC. 28213 4635-08-0635

LOCATION corner of Statts Rd and Shoreline Lp.

SUBDIVISION Imperial Pt. BLOCK / SECTION LOT 42 LOT AREA .6 SITE CLASS. PS DESIGN FLOW 360 L.T.A.R. .35

Septic Tank: 1000 Gallons; STB 794 Date 3-1-96

Pump Tank: Gallons; PT Date

Pump Make: Model Serial No.

Nitrification Field: No Fields 1 Square Feet 1028 Linear Feet 270

No Lines 3 Trench Width 36" Max Trench Bottom Depth 32" Gravel Depth N/A

[X] New System [ ] Repair System Type: I, II, (III), IV, V, VI

System Description: Drop distribution

Repair System Description: None

Maintenance Agreement Required: [ ] Yes [X] No

[X] House/Mod. Home No. Bedrooms 3

[ ] Mobile Home No. Bathrooms 3

[ ] Business No. Employees

[ ] Other


[ ] Slab [X] Crawl Space [ ] Basement w/plumbing [ ] Basement wo/plumbing

Water Supply: [X] Individual [ ] Community [ ] Public

Comments:

Comments:

INITIAL SITE SKETCH

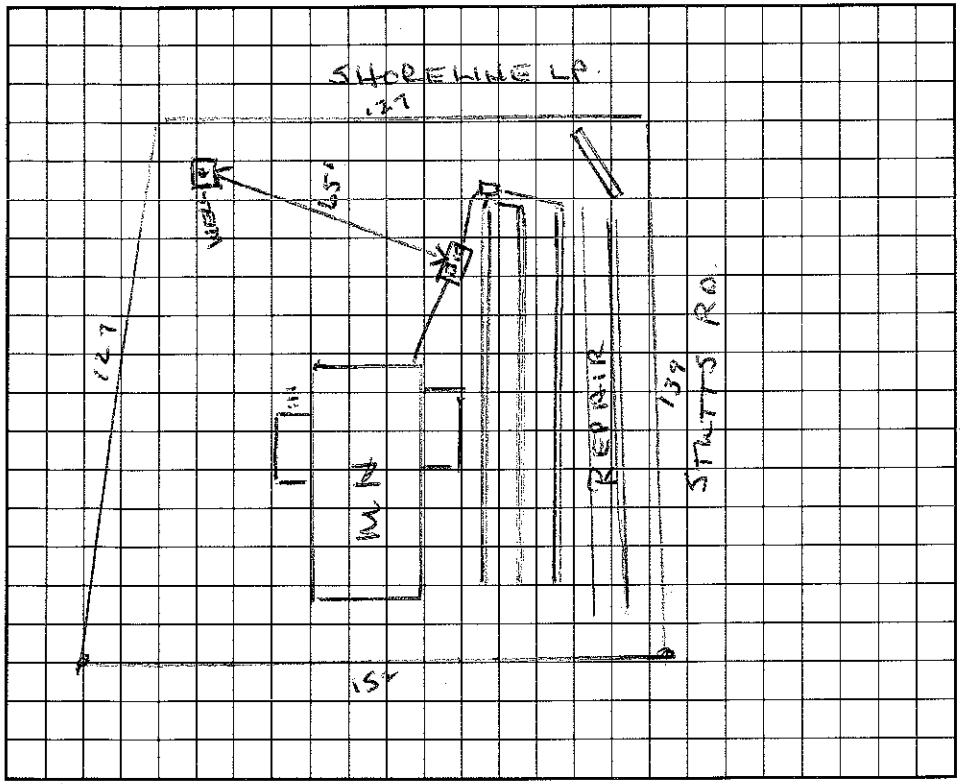

AS BUILT SKETCH

Same as site sketch

I understand that this permit can be suspended or revoked if any false information is supplied toward securing the permit/any unauthorized changes are made to the site/any unauthorized changes are made in the installation of the system.

Signed: Allen McKinney

Improvement Permit by: Wesley Sparks R.S. date 11/21/95

Authorization to Construct Existing system inspection by: Wesley Sparks R.S. date 11/21/95

Installed by: Cody CO

Certificate of Completion by: date

Operation Permit by: C. Bradley Green EHS date 5/3/96

HEALTH DEPT. COPY: WHITE INSPECTION COPY (FINAL): GREEN OWNER COPY (FINAL): YELLOW INSPECTION COPY (INITIAL): PINK OWNER COPY (INITIAL): GOLD