IREDELL COUNTY HEALTH DEPARTMENT

STATESVILLE 704-878-5305 MOORESVILLE 704-664-5281

IMPROVEMENT PERMIT / CERTIFICATE OF COMPLETION / OPERATION PERMIT / EXISTING SYSTEM INSPECTION

PROPERTY DESCRIPTION NO. 17633 DATE April 21, '95 TAX MAP NO. 2615A2 4635 68 2804 Watershed: ☑ Yes ☐ No WSIV

OWNER OR CONTRACTOR Peter L. Calame PHONE: Business _____ Home _____

ADDRESS 532 Statts Rd, Mooresville

LOCATION 1100 TL 1112, on left across from 1st Shoreline Loop entrance

SUBDIVISION Bayview Est. BLOCK / SECTION _____ LOT 56 LOT AREA ~24,000 ft² SITE CLASS: 85 per 1988 DESIGN FLOW 360 gpd L.T.A.R. .3

Septic Tank: 1000 Gallons; STB 794 Date 7/22/95

Pump Tank: 1000 Gallons; PT 47 Date 7/16/95

Pump Make: _____ Model _____ Serial No. _____

Nitrification Field: No Fields 1 Square Feet 900 Linear Feet 300

No Lines 4 Trench Width 36" Max Trench Bottom Depth 36" Gravel Depth NA

☑ New System ☐ Repair System Type: I, II, (III) IV, V, VI

System Description: pump/pm/ INNOVATOR LP PPBPS

Repair System Description: _____

Maintenance Agreement Required: ☐ Yes ☑ No

☐ House/Mod. Home No. Bedrooms 3

☐ Mobile Home No. Bathrooms 3

☐ Business No. Employees _____

☐ Other _____

☐ Slab ☐ Crawl Space ☑ Basement w/plumbing ☐ Basement wo/plumbing

Water Supply: ☑ Individual ☐ Community ☐ Public


Comments: Follow contour w/ laterals. See me for pressure manifold specs. DRH

This permit replaces permit issued 12/30/93

Comments:

1" = 50'

INITIAL SITE SKETCH

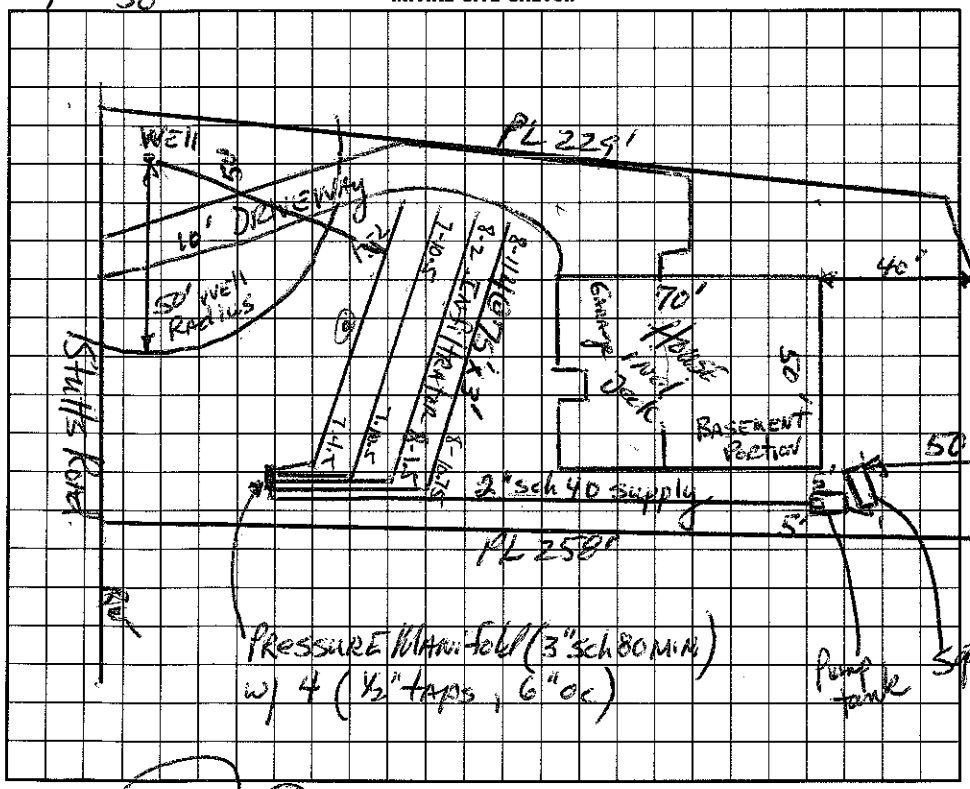

AS BUILT SKETCH

I understand that this permit can be suspended or revoked if any false information is supplied toward securing the permit/any unauthorized changes are made to the site/any unauthorized changes are made in the installation of the system. Improvement Permit is valid for 60 months from date of issuance.

Signed: _____

Improvement Permit by: Harold R. Hamm LS date 4/21/95

Existing System Inspection by: _____ date _____

Installed by: F J Ewin

Certificate of Completion by: Wesley Gardner LS date 8/25/95

Operation Permit by: _____ date _____

HEALTH DEPT. COPY: WHITE INSPECTION COPY (FINAL): GREEN OWNER COPY (FINAL): YELLOW INSPECTION COPY (INITIAL): PINK OWNER COPY (INITIAL): GOLD