IREDELL COUNTY HEALTH DEPARTMENT

STATESVILLE 704-878-5305 MOORESVILLE 704-664-5281

IMPROVEMENT PERMIT / CERTIFICATE OF COMPLETION / OPERATION PERMIT / EXISTING SYSTEM INSPECTION

PROPERTY DESCRIPTION NO. 20515 DATE July 21, 195 TAX MAP NO. 266A 118 4635 69 0544 Watershed: ☑ Yes ☐ No

OWNER OR CONTRACTOR Shannon Stamper PHONE: Business Home WS4

ADDRESS 116 Dolphin Drive, Mooresville

LOCATION Brawley Sch Rd. TL Stutts Rd TL Dolphin Dr. at end

SUBDIVISION Commodore BLOCK / SECTION LOT 118 LOT AREA SITE CLASS. PS = 1.96 DESIGN FLOW 360 gpd L.T.A.R. .3

Septic Tank: 1000 Gallons; STB 620 Date 4/22/96

Pump Tank: 1000 Gallons; PT 144 Date 7 3500psi

Pump Make: Zoeller Model .5 HP Serial No.

Nitrification Field: No Fields 4 Square Feet 900 Linear Feet 300

No Lines 6 Trench Width 36" Max Trench Bottom Depth 36" Gravel Depth N/A

☑ New System ☐ Repair System Type: I, II, III, IV, V, VI

System Description: pumped Infiltrator

Repair System Description: same

Maintenance Agreement Required: ☐ Yes ☑ No

☑ House/Mod. Home No. Bedrooms 3

☐ Mobile Home No. Bathrooms 3

☐ Business No. Employees

☑ Other


☐ Slab ☐ Crawl Space ☑ Basement w/plumbing ☐ Basement wo/plumbing

Water Supply:
☐ Individual
☑ Community
☐ Public

Comments:

Comments: Lines, TANKS, PRESSURE checked OK

INITIAL SITE SKETCH

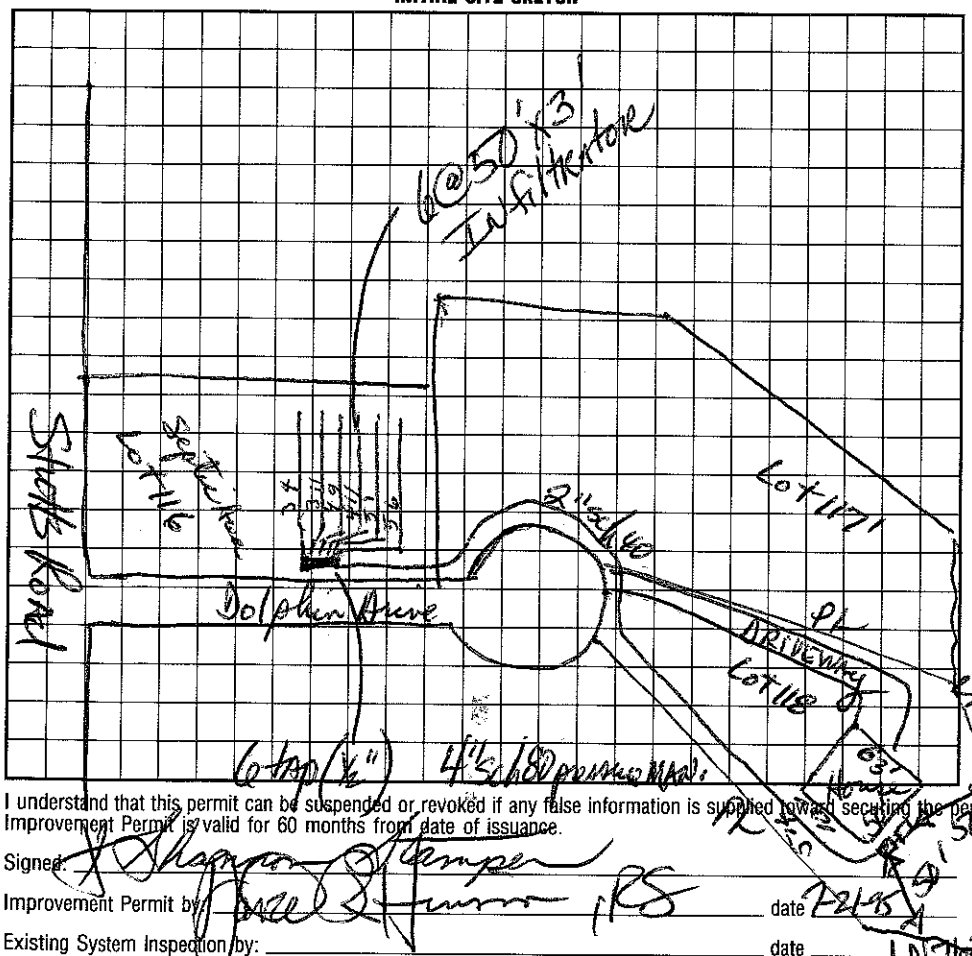

AS BUILT SKETCH

I understand that this permit can be suspended or revoked if any false information is supplied toward securing the permit/any unauthorized changes are made to the site/any unauthorized changes are made in the installation of the system. Improvement Permit is valid for 60 months from date of issuance.

Signed: X Shannon Stamper

Improvement Permit by: [illegible] RS date 7-24-95

Existing System Inspection by: date

Installed by: VNS SEPTIC

Certificate of Completion by: date

Operation Permit by: Wesley Sparks RS date 11/26/96

HEALTH DEPT. COPY: WHITE INSPECTION COPY (FINAL): GREEN OWNER COPY (FINAL): YELLOW INSPECTION COPY (INITIAL): PINK OWNER COPY (INITIAL): GOLD