IREDELL COUNTY HEALTH DEPARTMENT

STATESVILLE 704-878-5305 MOORESVILLE 704-664-5281

IMPROVEMENT PERMIT / CERTIFICATE OF COMPLETION / OPERATION PERMIT / EXISTING SYSTEM INSPECTIO

PROPERTY DESCRIPTION NO 14221 DATE Dec 20 '93 TAX MAP NO. 2G 6A 147 Watershed: ☐ Yes ☐ No

OWNER OR CONTRACTOR Dawn McBride PHONE: Business Home 4635-29-1938

ADDRESS

LOCATION 1100 TL 2nd 1212 on left corner lot w/ Marlin Dr.

SUBDIVISION Commodore Pen. BLOCK / SECTION LOT 147 LOT AREA ~10,000 sq ft SITE CLASS 5 per 1956 DESIGN FLOW 360 gpd L.T.A.R. .3

Septic Tank: 1000 Gallons; STB 358 ACP Date 11-20-93

Pump Tank: Gallons; PT Date

Pump Make: Model Serial No.

Nitrification Field: No Fields 1 Square Feet Linear Feet 200

No Lines 6 Trench Width 24" Max Trench Bottom Depth Gravel Depth N/A

☑ New System ☐ Repair System Type: I, II, III, IV, V, VI

System Description: gravity PPBPS

Repair System Description: grant for LPPPBPS

Maintenance Agreement Required: ☐ Yes ☑ No

☑ House/Mod. Home No. Bedrooms 3

☐ Mobile Home No. Bathrooms 2

☐ Business No. Employees

☐ Other

☐ Slab ☑ Crawl Space ☐ Basement w/plumbing ☐ Basement wo/plumbing


Water Supply: ☐ Individual ☑ Community ☐ Public

Comments:

Comments:

INITIAL SITE SKETCH

AS BUILT SKETCH

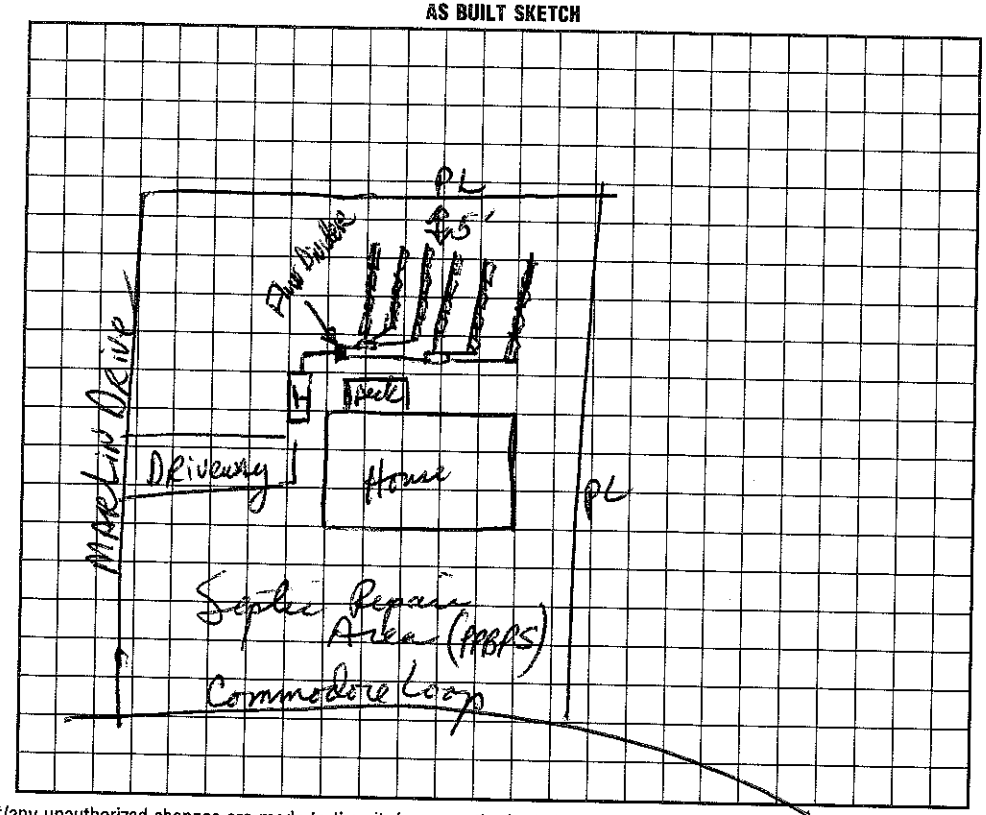

I understand that this permit can be suspended or revoked if any false information is supplied toward securing the permit/any unauthorized changes are made to the site/any unauthorized changes are made in the installation of the system. Improvement Permit is valid for 60 months from date of issuance.

Signed:

Improvement Permit by: date

Existing System Inspection by: date

Installed by: Richard Abernathy

Certificate of Completion by: date

Operation Permit by: date 12/20/93

HEALTH DEPT. COPY: WHITE INSPECTION COPY (FINAL): GREEN OWNER COPY (FINAL): YELLOW INSPECTION COPY (INITIAL): PINK OWNER COPY (INITIAL): GOLD