IREDELL COUNTY HEALTH DEPARTMENT

STATESVILLE 704-878-5305 MOORESVILLE 704-664-5281

IMPROVEMENT PERMIT / AUTHORIZATION TO CONSTRUCT / OPERATION PERMIT / EXISTING SYSTEM INSPECTION

PERMIT# 090909 PIN# 4635 69 2657 DATE 9/6/00

OWNER OR CONTRACTOR Bob Stilp PHONE: Business 663-4655 Home

ADDRESS 108 Tweed Place Mooresville, NC. 28117

LOCATION 1100 TL Stutts TL 2nd Commodore, 4th lot on (R) 305 Commodore Loop

SUBDIVISION Commodore BLOCK / SECTION LOT 108 LOT AREA .257 SITE CLASS. PS DESIGN FLOW 360 L.T.A.R. .3

Septic Tank: Penncraft 1000 Gallons; STB 1012 Date 9/31/00

Pump Tank: 1000 Gallons; PT 17 Date 10/7/2000

Pump Make: Meyers Model ME 40 Serial No.

Nitrification Field: No Fields 1 Square Feet 600 Linear Feet 200

No Lines 3 Trench Width 3' Max Trench Bottom Depth 3'

[X] New System [ ] Repair System Type: I, II, III, (IV) V, VI

System Description: LPP BLST. - 16" PP 35 50%

Repair System Description: None - < 1977 Recording

Maintenance Agreement Required: [X] Yes [ ] No

~~Gravel Depth~~ 6" SAND.

[X] House/Mod. Home No. Bedrooms 3

[ ] Mobile Home No. Bathrooms 2

[ ] Business No. Employees

[ ] Other 1/2


[ ] Slab [ ] Crawl Space [ ] Basement w/plumbing [X] Basement wo/plumbing

Water Supply: [ ] Individual [ ] Public [X] Community

Comments:/Conditions: 50% reduced system to be used - install whats shown on this permit. Requires Maintenance Contract.

Comments:/Conditions: Floats were not set on Initial Inspection.

INITIAL SITE SKETCH (1" = 40')

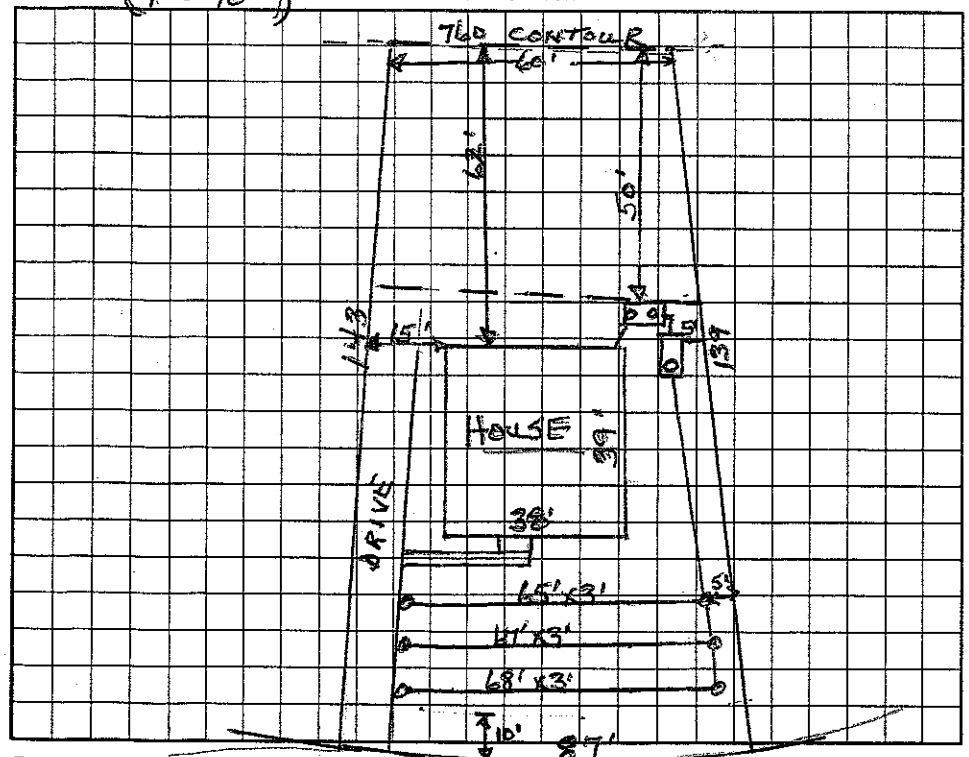

AS BUILT SKETCH

Permit can be suspended or revoked if any false information is supplied toward securing the permit/any unauthorized changes are made to the site/any unauthorized changes are made in the installation of the system. Improvement Permit with plat valid without expiration. Improvement Permit with site plan valid for sixty months. Authorization to Construct is valid for a period equal to that of Improvement Permit – not to exceed sixty months.

Signed: [signature] date

Improvement Permit by: Wesley Sparks RS. date 9/6/00

Authorization to Construct by: Wesley Sparks RS date 9/6/00

Installed by: Richard Abernathy

Operation Permit by: [signature] RSI date 6/13/01

Existing System Inspection by: date

HEALTH DEPT. COPY: WHITE OWNER COPY (FINAL): YELLOW OWNER COPY (INITIAL): PINK