IREDELL COUNTY HEALTH DEPARTMENT

STATESVILLE 704-878-5305 375.00 Paid MOORESVILLE 704-664-5281

IMPROVEMENT PERMIT / AUTHORIZATION TO CONSTRUCT / OPERATION PERMIT / EXISTING SYSTEM INSPECTION

PERMIT# 11961 PIN# 4635 69 3405 DATE 6/2/04

OWNER OR CONTRACTOR Sherry & Alan Brown PHONE: Business 704-677-3183 Home

ADDRESS 244 Commodore Lp. Mooresville, NC. 28117

LOCATION 297 Commodore Lp. Mooresville, NC 1 2 NO Commodore Lp. on (R) before Sunfish Ln.

SUBDIVISION Commodore Pen. BLOCK / SECTION LOT 105 LOT AREA .31 Ac SITE CLASS. PS DESIGN FLOW 360 L.T.A.R. .3

Septic Tank: 1000 Gallons: STB 312 Date 5/3/05
Pump Tank: 1000 Gallons: PT 27 Date 4/30/05
Pump Make: Model Serial No.
Nitrification Field: No Fields 1 Square Feet 400 Linear Feet 200
No Lines 5 @ 40' Trench Width 2-3' Max Trench Bottom Depth 3' Gravel Depth No

[X] New System [ ] Repair System Type: I, II, III, IV, V, VI
System Description: Pressured - 16" PPBPS
Repair System Description: < 1983 platting
Maintenance Agreement Required: [X] Yes [ ] No Partial


[X] House/Mod. Home No. Bedrooms 3
[ ] Mobile Home No. Bathrooms 3
[ ] Business No. Employees
[ ] Other
[ ] Slab [ ] Crawl Space [X] Basement w/plumbing [ ] Basement wo/plumbing

Water Supply: [ ] Individual [ ] Public [X] Community


Comments:/Conditions: This is a 50% reduced system. NO Changes are possible on this layout. Riser. MAINTENANCE CONTRACT IS REQUIRED.

Comments:/Conditions: 30, 27, 24, 33, 35, 30, 24 - Line lengths

INITIAL SITE SKETCH (1" = 40')

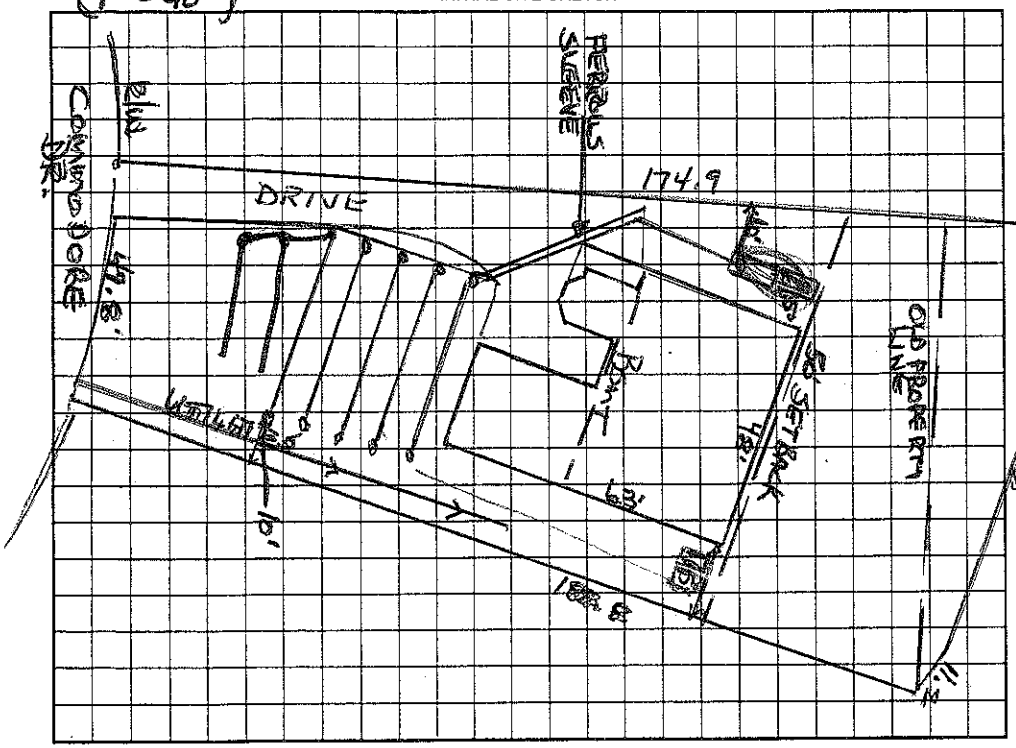

AS BUILT SKETCH

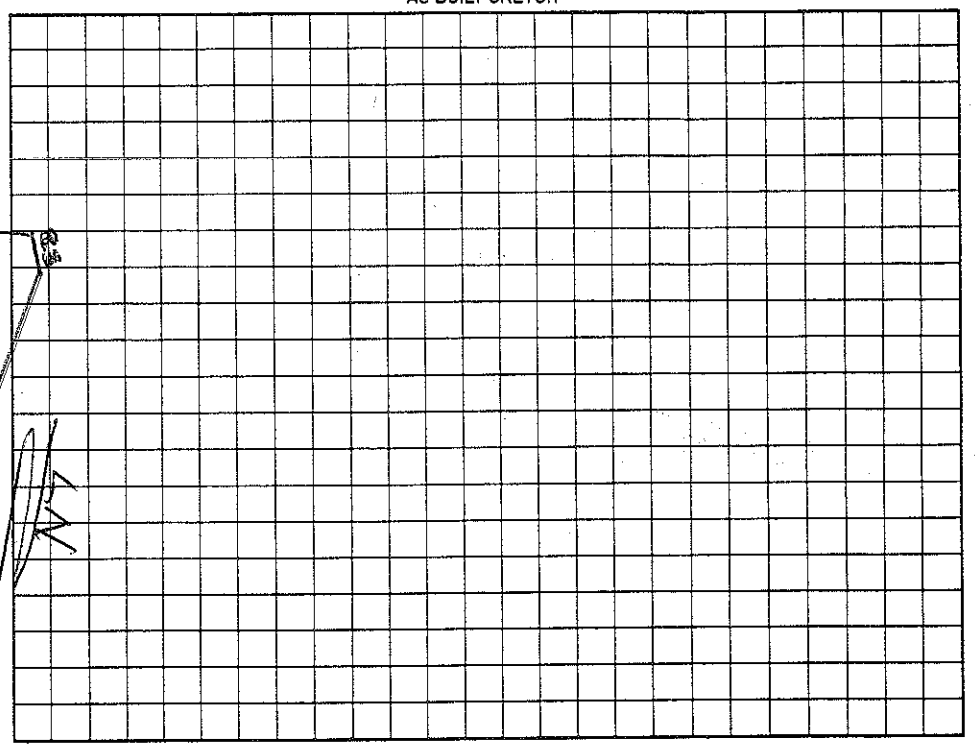

Permit can be suspended or revoked if any false information is supplied toward securing the permit/any unauthorized changes are made to the site/any unauthorized changes are made in the installation of the system. Improvement Permit with plat valid without expiration. Improvement Permit with site plan valid for sixty months. Authorization to Construct is valid for a period equal to that of Improvement Permit – not to exceed sixty months.

Signed: [signature] date 6/3/04 Installed by: Richard Abernathy

Improvement Permit by: Wesley Sparks R.S. date 6/2/04 Operation Permit by: Wesley Sparks R.S. date 6/29/05

Authorization to Construct by: Wesley Sparks R.S. date 6/2/04 Existing System Inspection by: date

HEALTH DEPT. COPY: WHITE OWNER COPY (FINAL): YELLOW OWNER COPY (INITIAL): PINK