IREDELL COUNTY HEALTH DEPARTMENT

Statesville Office (704) 878-5305 Mooresville Office (704) 660-3625 PERMIT # 218772

IMPROVEMENT PERMIT / AUTHORIZATION TO CONSTRUCT / OPERATION PERMIT / EXISTING SYSTEM

PIN # 4635694649

APPLICANT: True Homes APPLICANT ADDRESS: 2649 Brekonridge Ctr Dr Monroe, NC 28110

SITE ADDRESS: 300 Commodore Lp. Mooresville, NC 28110 PHONE: 7042385229 ALT. PHONE:

SITE DIRECTIONS: Brawley School Rd to Stutts Rd TL Commodore Lp on right (not on lakeside)


SUBDIVISION: Commodore Peninsula SECTION: -1- LOT # 159 LOT AREA: DESIGN FLOW: 360gpd L.T.A.R.: .3

Septic Tank	060 (gal)	STB	2071	Date	INFILTRATOR	☒ New System	☐ Repair	☐ Expansion	System Type: I II III IV V VI	☒ Residence	No. Bedrooms	3	Water Supply
Pump Tank	1060 (gal)	PT	2071	Date	11/17/2016	System Description:	LP PPBPS			☐ Business	No. Persons	6	☐ Private
Pump Make	ZOELLER	Model	N151	Serial #	8316	Repair System Description:	Part. (Lot recorded 1962)			☐ Other	No. Employees		☒ Public
# Nitrification Fields	1	# Lines	5	Linear Ft:	200	Maintenance Agreement Required:	☒ YES	☐ NO		☐ Slab	☒ Crawl Space		☒ Community
Trench Width	min 24"	Max. Trench Bottom Depth	36"	Gravel Depth	N/A		☐ GRAVITY	☒ PRESSURE		☐ Basement w/ plumbing			☐ Basement w/o plumbing

Comments / Conditions: A Septic System must be at least 5FT from PL. No drain around house if 5FT setback used

* Lot exempt from required repair 7/27/16 Reviewed Floor plans, in compliance with I.P.

INITIAL SITE SKETCH

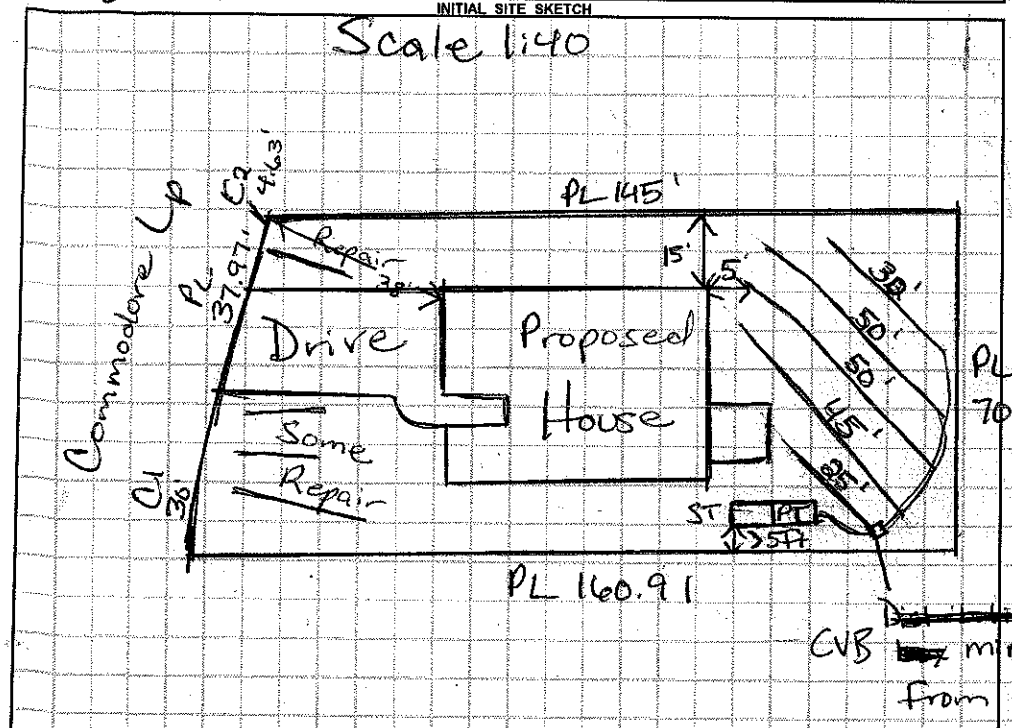

AS BUILT SKETCH

	Date	Initials
Drain Lines Checked	11-17	US
Tanks Checked	11-17	US
Pressure Manifold or Valve Box Checked	11-17	US
Pressure Head Set	11-17	US
Electrical Checked	11-17	BA
Floats Set	11-17	BA
Alarm Checked	11-17	BA
Maintenance Contract (Y) N	11-17	BA
Comments:		

Permit can be suspended or revoked if any false information is supplied toward securing the permit / any unauthorized changes are made to the site / any unauthorized changes are made in the installation of the system. **CONTACT A LOCATOR SERVICE PRIOR TO ANY EXCAVATION**


☐ **IMPROVEMENT PERMIT** *with plat valid without expiration.* ☒ **IMPROVEMENT PERMIT** *with site plan valid for 60 mos.* ☐ **AUTHORIZATION TO CONSTRUCT** *valid for period equal to IMPROVEMENT PERMIT--not to exceed 60 mo.*

Owner / Applicant Signature: Date: 8/5/16 Installed by: Delhagen Brothers

IMPROVEMENT PERMIT by: Maria Soto RS Date: 7/23/16 OPERATION PERMIT by: BA Date: 11-18-16

AUTHORIZATION TO CONSTRUCT by: Maria Soto RS Date: 7/27/16 Existing System Inspected by: Date:

Health Dept. Copy - WHITE Applicant (Final Approval) - YELLOW Applicant (Conditional Approval) - PINK

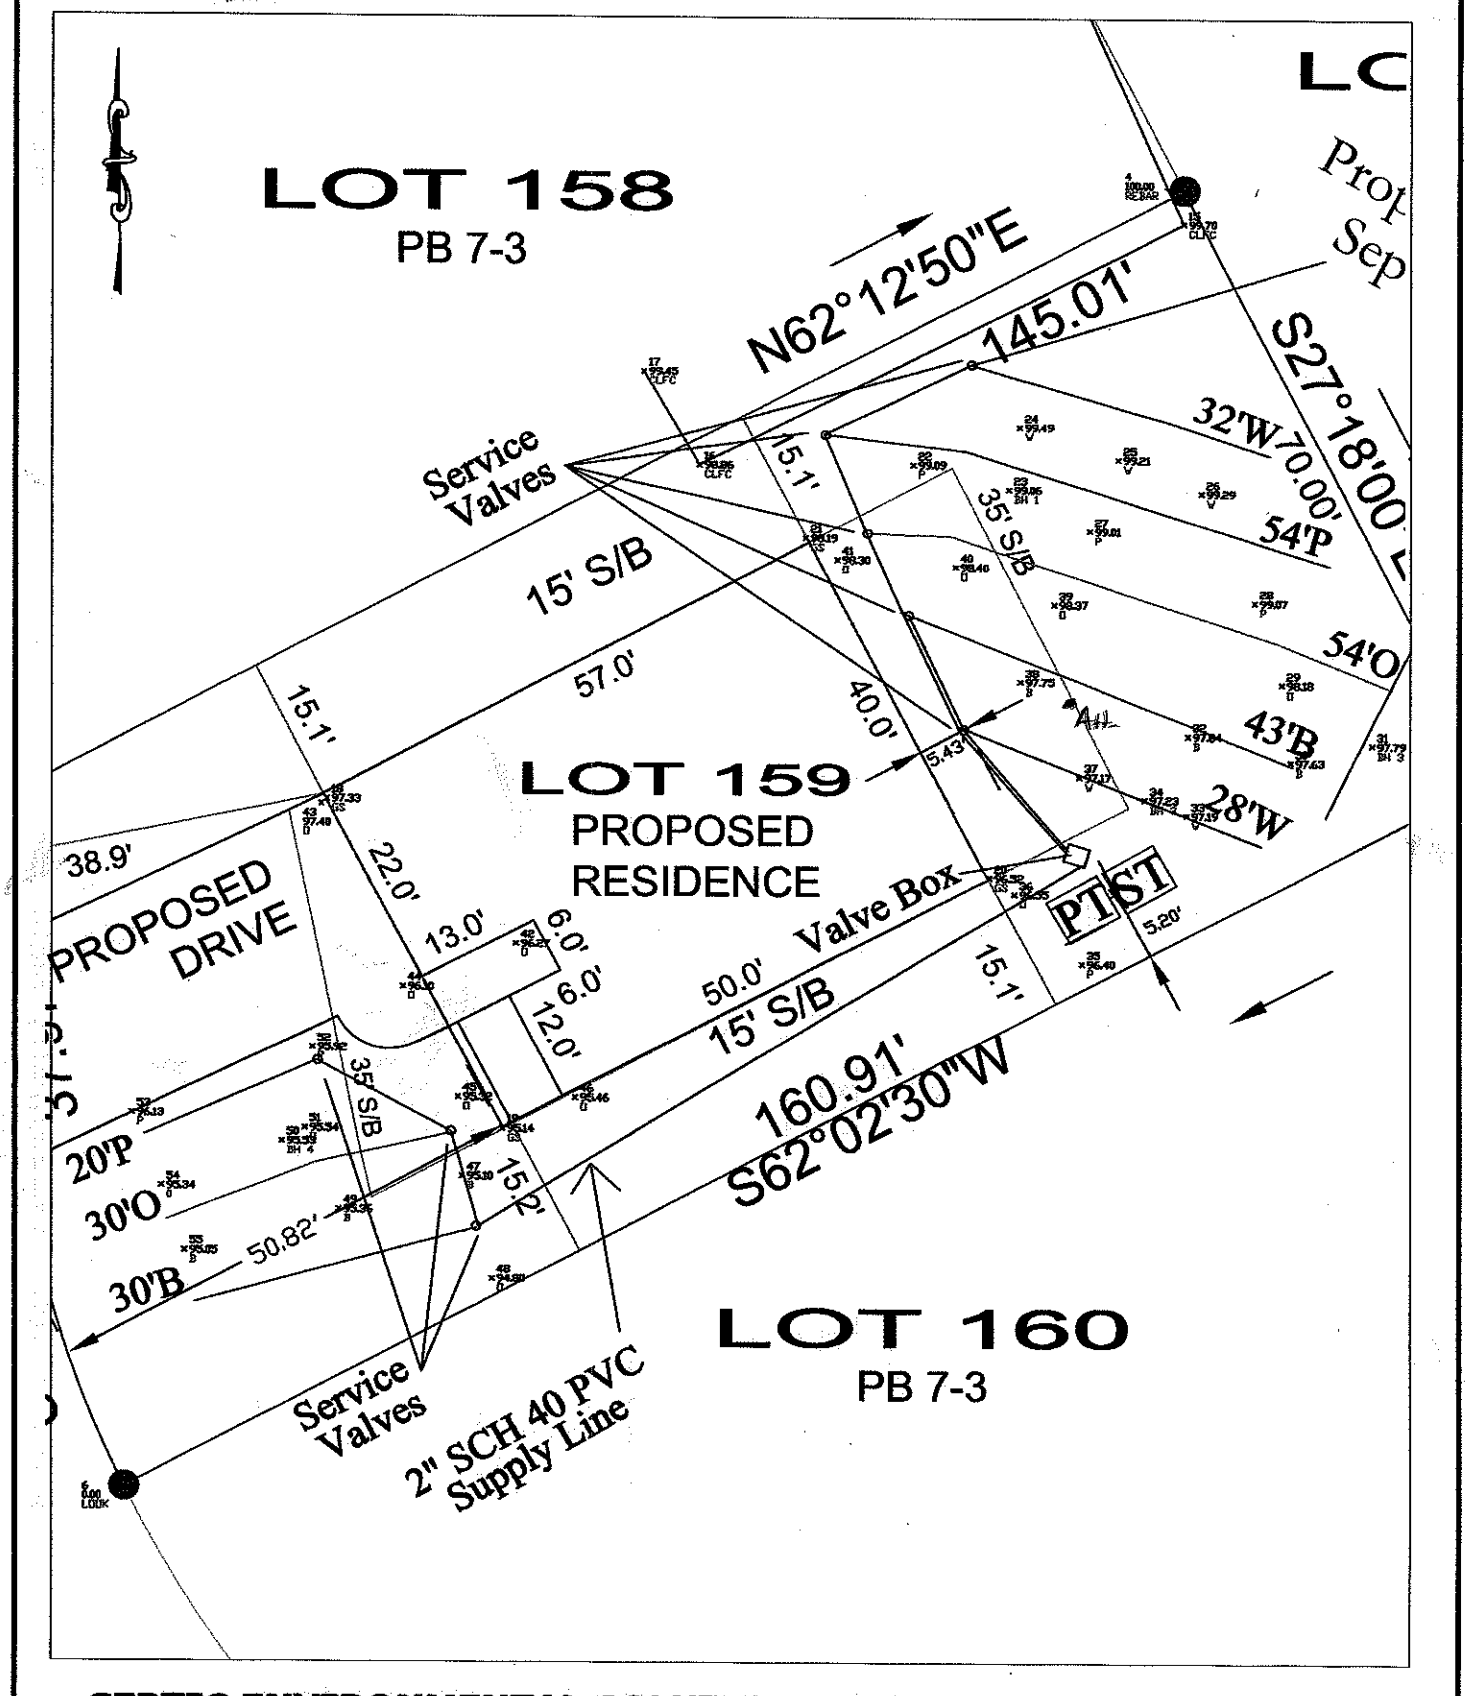

SEPTIC ENVIRONMENTAL SOLUTIONS, INC.

3019 SPRING FANCY LANE, INDIAN TRAIL, NORTH CAROLINA, 704-502-5588

20' 0' 10' 20'

1" = 20'