4635 69 L251

IREDELL COUNTY HEALTH DEPARTMENT

STATESVILLE 704-878-5305 MOORESVILLE 704-664-5281

IMPROVEMENT PERMIT / CERTIFICATE OF COMPLETION / OPERATION PERMIT / EXISTING SYSTEM INSPECTION

PROPERTY DESCRIPTION NO. 14913 DATE June 1, '93 TAX MAP NO. 2G-6-A 97

OWNER OR CONTRACTOR Paul Taylor PHONE: Business Home

ADDRESS

LOCATION SR 1100 TR 1113 TL 2nd 1212 TR Surfside Dr. 114 SURFSIDE LN ON Right 1/10 mile

SUBDIVISION Commodore Peninsula BLOCK / SECTION LOT 97 LOT AREA Existing since '62 SITE CLASS. PS L.T.A.R. .13

Water Supply: ☐ Individual ☑ Community ☐ Public

Septic Tank: 1000 Gallons; STB Date

Pump Tank: 1000 Gallons; PT Date

Nitrification Field: No. Fields 1 Square Feet Linear Feet 200

No Lines 6 Trench Width 24" Trench Depth Gravel Depth NA

☑ New System ☐ Repair System Type: I, II, III, IV, V, VI

System Description: Pressure PPBPS

Repair System Description: SAME

Maintenance Agreement Required: ☑ Yes ☐ No

☑ House/Mod. Home No. Bedrooms 3

☐ Mobile Home No. Bathrooms 2

☐ Business No. Employees —

☐ Other

Garbage Disposal: ☑ Yes ☐ No

Auto. Dishwasher: ☑ Yes ☐ No


Auto. Washing Machine: ☑ Yes ☐ No

Other


☐ Slab ☑ Crawl Space ☐ Basement w/plumbing ☐ Basement wo/plumbing

Comments System installed on May 11, '93, #'s on ST & PT not available unless uncovered, MAINTENANCE Agreement received 6/1/93

INITIAL SITE SKETCH

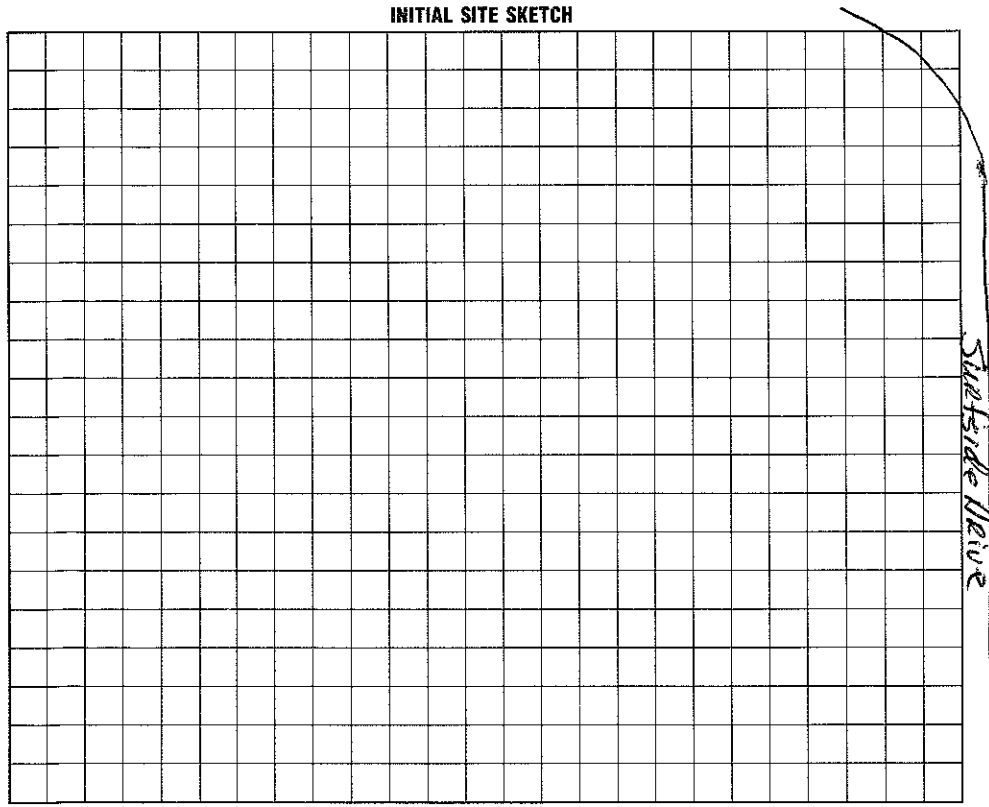

AS BUILT SKETCH

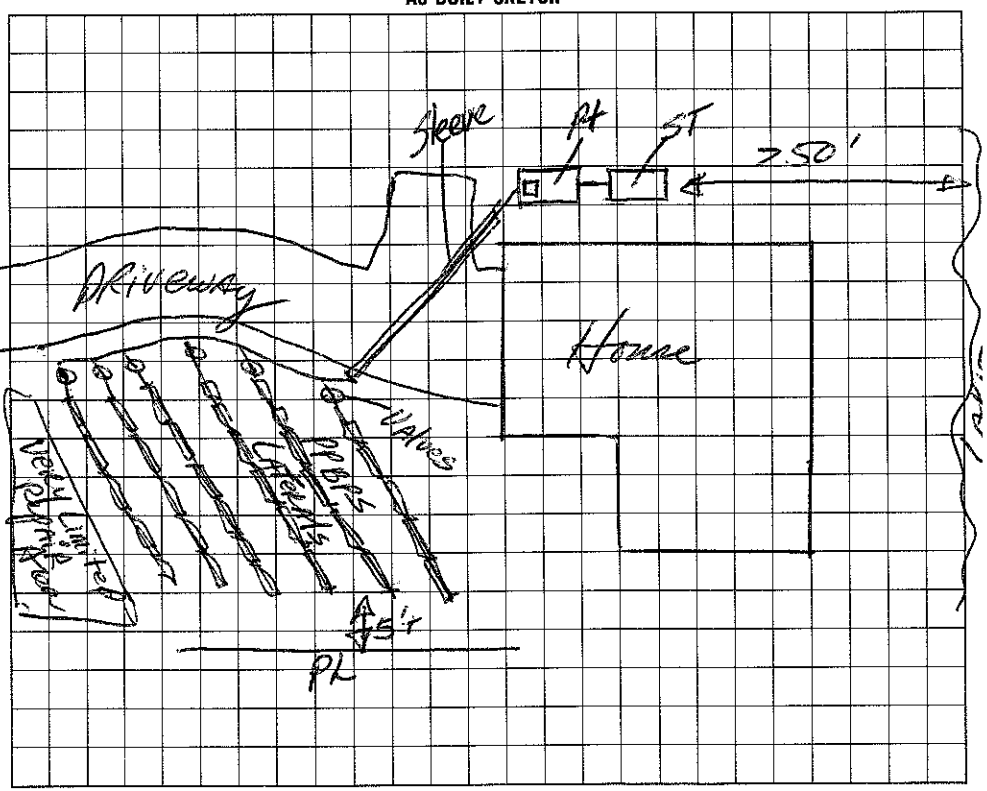

I understand that this permit can be suspended or revoked if any false information is supplied toward securing the permit/any unauthorized changes are made to the site/any unauthorized changes are made in the installation of the system. Improvement Permit is valid for 60 months from date of issuance.

Signed:

Improvement Permit by: date

Existing System Inspection by: date

Installed by: Richard Abernathy

Certificate of Completion by: date

Operation Permit by: Jack R Henson, RS date 6/1/93

HEALTH DEPT. COPY: WHITE INSPECTION COPY (FINAL): GREEN OWNER COPY (FINAL): YELLOW INSPECTION COPY (INITIAL): PINK OWNER COPY (INITIAL): GOLD