4635697170

IREDELL COUNTY HEALTH DEPARTMENT

(SEPTIC TANK) IMPROVEMENTS PERMIT AND CERTIFICATE OF COMPLETION

(Ground Absorption Sewage Disposal System – G. S. Chapter 130-Article 13C)

OWNER OR CONTRACTOR Herbert Klippel DATE 6-29-83 PERMIT NO. 215

PHONE: Business _____ Home _____

LOCATION 1108 N 1112 N 2nd 1212 N Sanford 2nd house on Rt. S. R. No. _____

SUBDIVISION NAME Commodore Pen. LOT NO. 95 SECTION OR BLOCK NO. _____

House (✓) Mobile Home ( ) Business ( ) Other Adding Utility Bldg

No. Bedrooms _____ No. Bathrooms _____

Garbage Disposal Unit	Yes ( )	No ( )
Auto. Dishwasher	Yes ( )	No ( )
Auto. Wash. Machine	Yes ( )	No ( )
Site Suitable	Yes ( )	No ( )

Character & Porosity of Soil _____

Percolation Rate _____


Topography _____

Depth to Water Table _____

Rock or other impervious formations _____

Lot Area _____

_____ Basement with Plumbing _____ Basement without Plumbing _____ No Basement

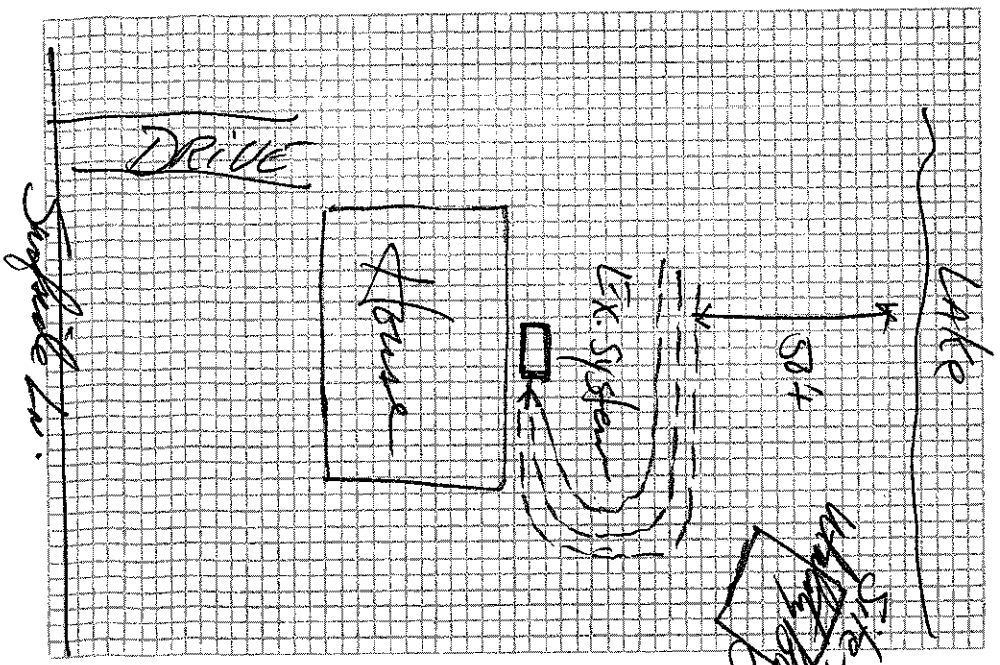

Plot of System

Size of Tank Existing Gals.

Nitrification Field:

No. of Lines Existing

Sq. Ft. _____ Linear Ft. _____

Depth of Stone in Lines _____

Water Supply: Individual ( )

Public (✓)

Installed by _____

I understand and agree to install septic tank system as specified on this Improvements Permit.

Signed: _____

IMPROVEMENTS PERMIT BY _____

COMMENTS: Existing system ok at time of inspection

CERTIFICATE OF COMPLETION BY _____ DATE _____

EXISTING SYSTEM CHECKED BY: _____ DATE 6-29-83

CONSTRUCTION MUST COMPLY WITH ALL OTHER APPLICABLE STATE AND LOCAL REGULATIONS.

Permit is VOID if any unauthorized changes are made in installation of system and/or if any false information is supplied in making Improvements Permit.

Health Dept. Copy: White Inspection Dept. Copy: Yellow Sanitarian's Copy: Pink Owner's Copy: Gold

IREDELL COUNTY HEALTH DEPARTMENT

(SEPTIC TANK) IMPROVEMENTS PERMIT AND CERTIFICATE OF COMPLETION

(Ground Absorption Sewage Disposal System – G. S. Chapter 130-Article 13C)

OWNER OR CONTRACTOR Ed miller DATE 4-3-75 PERMIT NO. 56

PHONE: Business _____ Home 938-3616

LOCATION 1100 TL on 1112 Surfside Drive on right

S. R. No. 1112

SUBDIVISION NAME Commodore Penn. LOT NO. 95 SECTION OR BLOCK NO. _____

House (✓) Mobile Home ( ) Business ( ) Other _____

No. Bedrooms 3 No. Bathrooms 3

Garbage Disposal Unit Yes (✓) No ( )

Auto. Dishwasher Yes (✓) No ( )

Auto. Wash. Machine Yes (✓) No ( )

Site Suitable Yes (✓) No ( )

Character & Porosity of Soil Clay loam Porosity Fair


Percolation Rate not taken

Topography 2% Slope

Depth to Water Table Bottom of Ditch is 1' above lake level

Rock or other impervious formations _____

Lot Area 15000 Sq feet

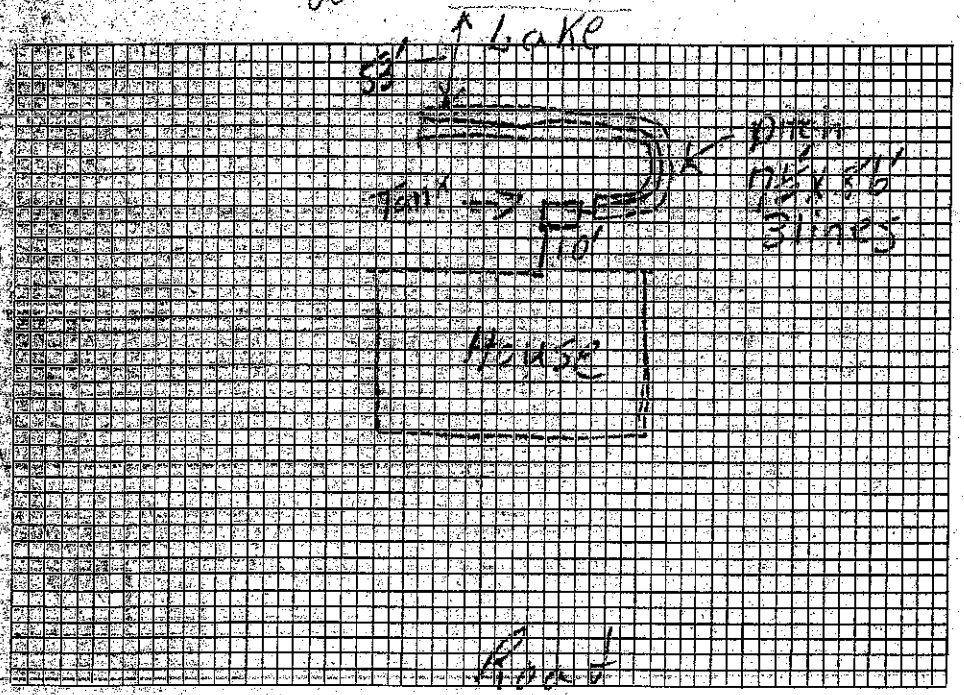

Plot of System

Size of Tank 1250 Gals.

Nitrification Field:

No. of Lines 3

Sq. Ft. 625 Linear Ft. 250

Depth of Stone in Lines 10"

Water Supply: Individual ~~(✓)~~

Public (✓)

Commodore Penn Water System

Installed by F. J. Ervin

IMPROVEMENTS PERMIT BY John Houston

COMMENTS: System was installed according to improvements permit

CERTIFICATE OF COMPLETION BY J. C. Moore DATE 4-3-75

CONSTRUCTION MUST COMPLY WITH ALL OTHER APPLICABLE STATE AND LOCAL REGULATIONS.

Health Dept. Copy: White Inspection Dept. Copy: Yellow Sanitarian's Copy: Pink Owner's Copy: Gold