IREDELL COUNTY HEALTH DEPARTMENT

STATESVILLE 704-878-5305 MOORESVILLE 704-664-5281

IMPROVEMENT PERMIT / AUTHORIZATION TO CONSTRUCT / OPERATION PERMIT / EXISTING SYSTEM INSPECTION

PERMIT# 071543 PIN# 4635698379 DATE 1/29/98

OWNER OR CONTRACTOR Loren Fresh PHONE: Business 330-2067 Home 664-5532

ADDRESS 115 Surfside Dr. Mooresville, NC

LOCATION Brawley School Rd TL Stutts Rd TL 2nd Commodore Est. TR Surfside 1st House on left

SUBDIVISION Commodore Point BLOCK / SECTION _____ LOT 68 & 69 LOT AREA _____ SITE CLASS. PS DESIGN FLOW 480 gpd L.T.A.R. .3+

Septic Tank: Existing 1000 Gallons; STB _____ Date 65,67,68

Pump Tank: _____ Gallons; PT _____ Date _____

Pump Make: _____ Model _____ Serial No. _____

Nitrification Field: No Fields 1 Square Feet 875' Linear Feet 350'

No Lines 2 at 175' Trench Width 5'-6" Max Trench Bottom Depth 36" Gravel Depth 12"

X New System X Repair System Type: I, II, III, IV, V, VI Expl.

System Description: Grav. Conv Bed 5'x125'

Repair System Description 4 grav Conv Bed 5'x175'

Maintenance Agreement Required: ☐ Yes ☐ No

X House/Mod. Home No. Bedrooms 4

☐ Mobile Home No. Bathrooms ____

☐ Business Upgrade No. Employees ____

☐ Other Adding a Bedroom


☐ Slab ☐ Crawl Space ☐ Basement w/plumbing ☐ Basement wo/plumbing

Water Supply: ☐ Individual ☐ Public X Community

Comments:/Conditions: Keep Drainfield at least 5' from House & 10' from Road ROW

Comments:/Conditions:

INITIAL SITE SKETCH Scale: 1:50

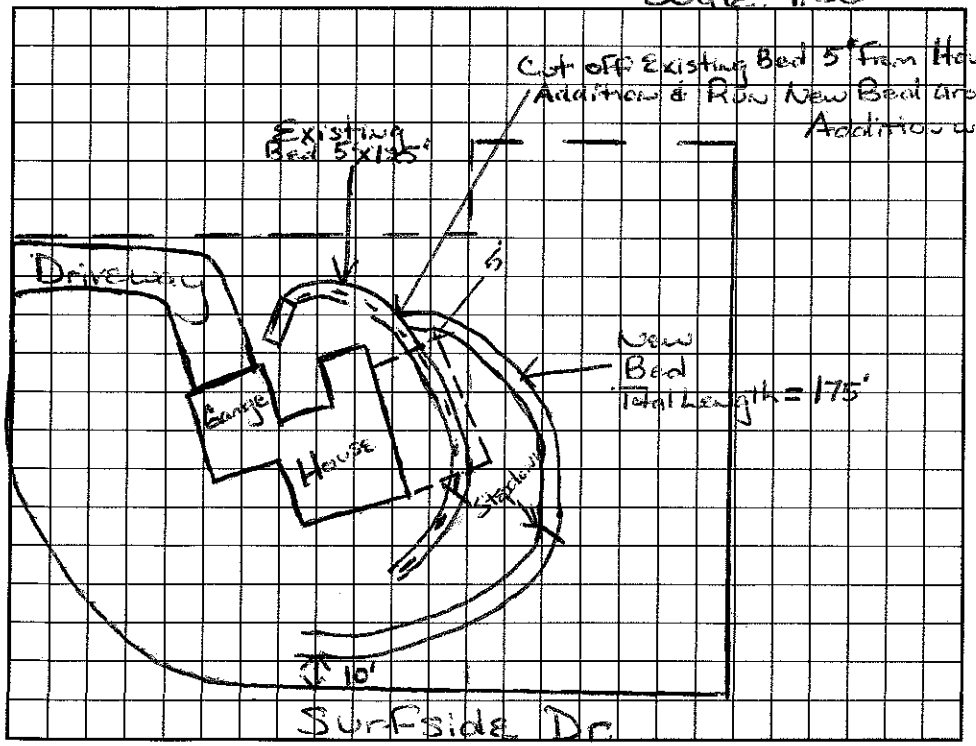

AS BUILT SKETCH

I understand that this permit can be suspended or revoked if any false information is supplied toward securing the permit/any unauthorized changes are made to the site/any unauthorized changes are made in the installation of the system. Improvement Permit with plat valid without expiration. Improvement Permit with site plan valid for sixty months. Authorization to Construct is valid for a period equal to that of Improvement Permit – not to exceed sixty months.

Signed: Loren Fresh date 2-16-98 Installed by: Piedmont Backhoe

Improvement Permit by: Maia Dotson date 1/30/98 Operation Permit by: Maia Dotson date 7/14/98

Authorization to Construct by: Maia Dotson date 1/30/98 Existing System Inspection by: Maia Dotson date 7/14/98

HEALTH DEPT. COPY: WHITE INSPECTION COPY (FINAL): GREEN OWNER COPY (FINAL): YELLOW INSPECTION COPY (INITIAL): PINK OWNER COPY (INITIAL): GOLD