MD

IREDELL COUNTY HEALTH DEPARTMENT

Statesville Office (704) 878-5305 Mooresville Office (704) 660-3625 PERMIT # 213500

IMPROVEMENT PERMIT / AUTHORIZATION TO CONSTRUCT / OPERATION PERMIT / EXISTING SYSTEM

PIN # 4635-69-9780.000

APPLICANT: Jody Davis APPLICANT ADDRESS: 702 A Brawley School Rd. Mooresville NC

SITE ADDRESS: 266 Commodore Ln. Mooresville NC PHONE: 704-905-7582 ALT. PHONE: 704-957-2066

SITE DIRECTIONS: BSR, TL Stutts, TL Commodore Ln.

SUBDIVISION: Commodore Peninsula SECTION: — LOT # 167 LOT AREA: DESIGN FLOW: 360 GPD L.T.A.R.: —

Septic Tank 1000 (gal) STB 794 Date 8-13-15 — ☐ New System ☑ Repair ☐ Expansion System Type: I II (III) IV V VI — ☑ Residence No. Bedrooms 3 — Water Supply: ☐ Private ☐ Public ☒ Community

Pump Tank (gal) PT Date — System Description: — ☐ Business No. Persons 6


Pump Make Model Serial # — Repair System Description: 25% Reduction - Gravity — ☐ Other No. Employees

Nitrification Fields 1 # Lines Existing Linear Ft: Existing — Maintenance Agreement Required: ☐ YES ☐ NO — ☐ Slab ☒ Crawl Space


Trench Width Existing Max. Trench Bottom Depth Existing Gravel Depth Existing — ☐ GRAVITY ☐ PRESSURE — ☐ Basement w/plumbing ☐ Basement w/o plumbing

Comments / Conditions: Crush And Fill Existing Tank. Install New Tank And Hook Plumbing Back In As In Existing Tank. Maintain 10' Off Property Line And 5' Off Any Building Structures.

INITIAL SITE SKETCH

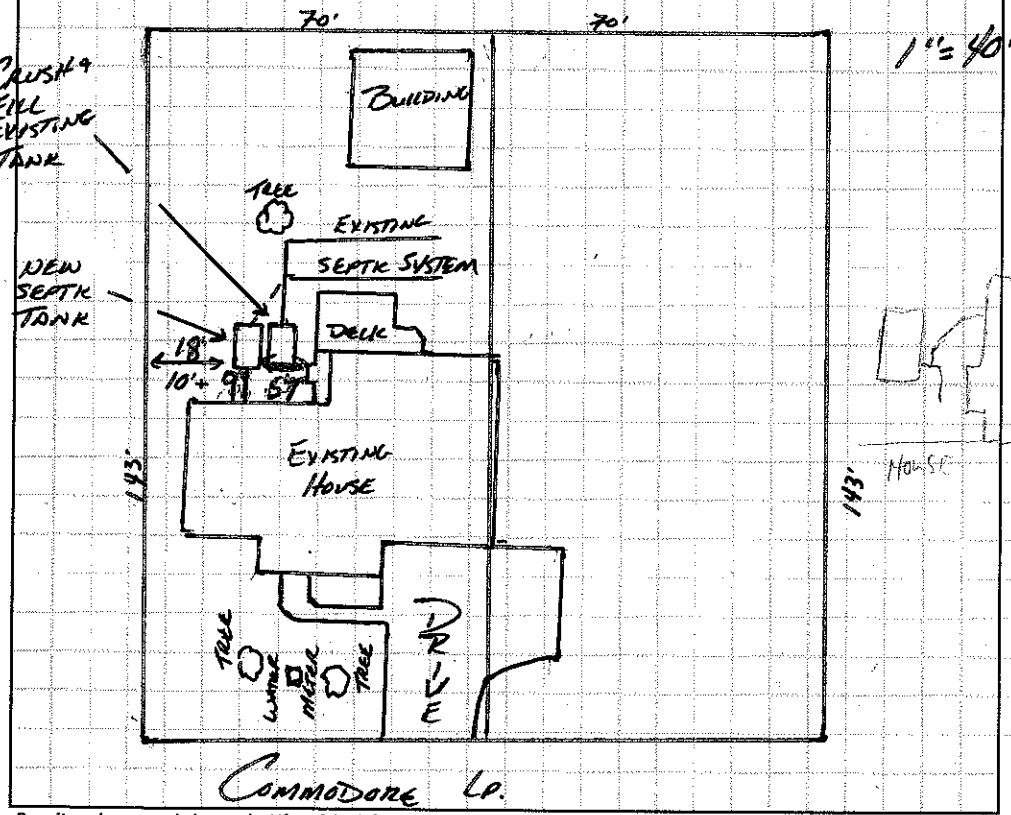

AS BUILT SKETCH

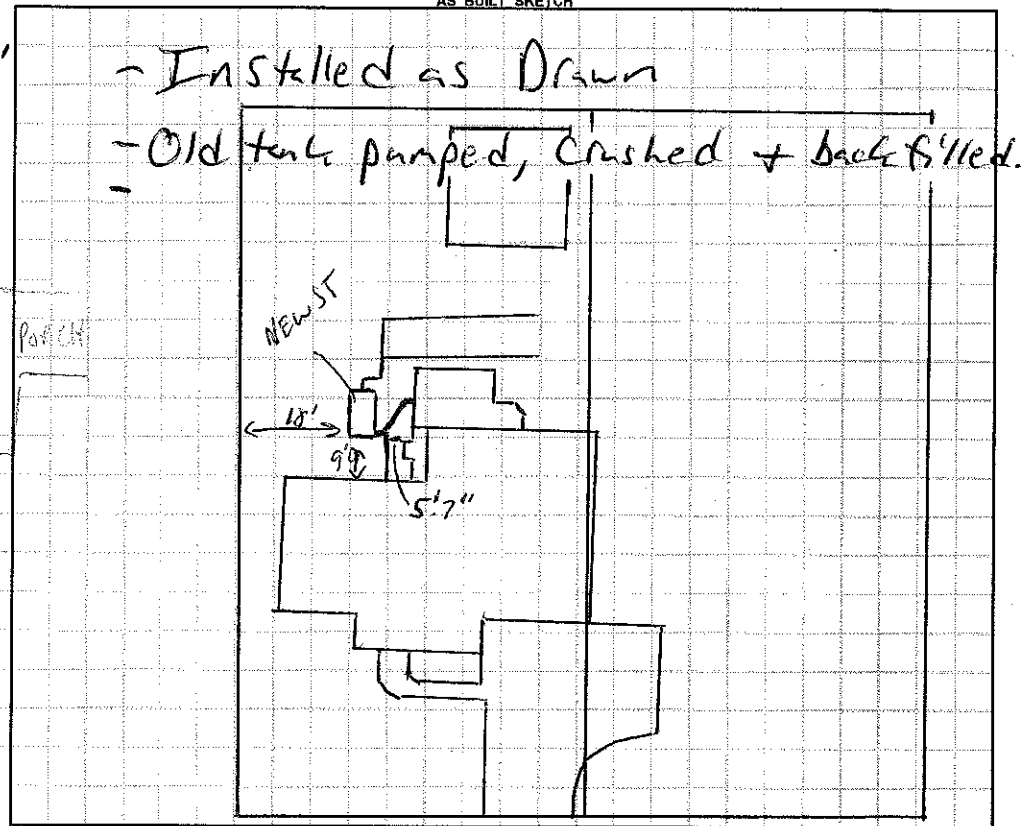

Permit can be suspended or revoked if any false information is supplied toward securing the permit / any unauthorized changes are made to the site / any unauthorized changes are made in the installation of the system. **CONTACT A LOCATOR SERVICE PRIOR TO ANY EXCAVATION**

☐ **IMPROVEMENT PERMIT** *with plat valid without expiration.* ☒ **IMPROVEMENT PERMIT** *with site plan valid for 60 mos.* ☒ **AUTHORIZATION TO CONSTRUCT** *valid for period equal to IMPROVEMENT PERMIT--not to exceed 60 mo.*

Owner / Applicant Signature: Date: 9-16-15 Installed by: Waste Water Solutions

IMPROVEMENT PERMIT by: Date: APPROVED SEP 14 2015 OPERATION PERMIT by: Date: 9-17-15

AUTHORIZATION TO CONSTRUCT by: Date: APPROVED SEP 14 2015 Existing System Inspected by: Date:

Health Dept. Copy - WHITE Applicant (Final Approval) - YELLOW Applicant (Conditional Approval) - PINK